


T.28S., R.12W., W.M.

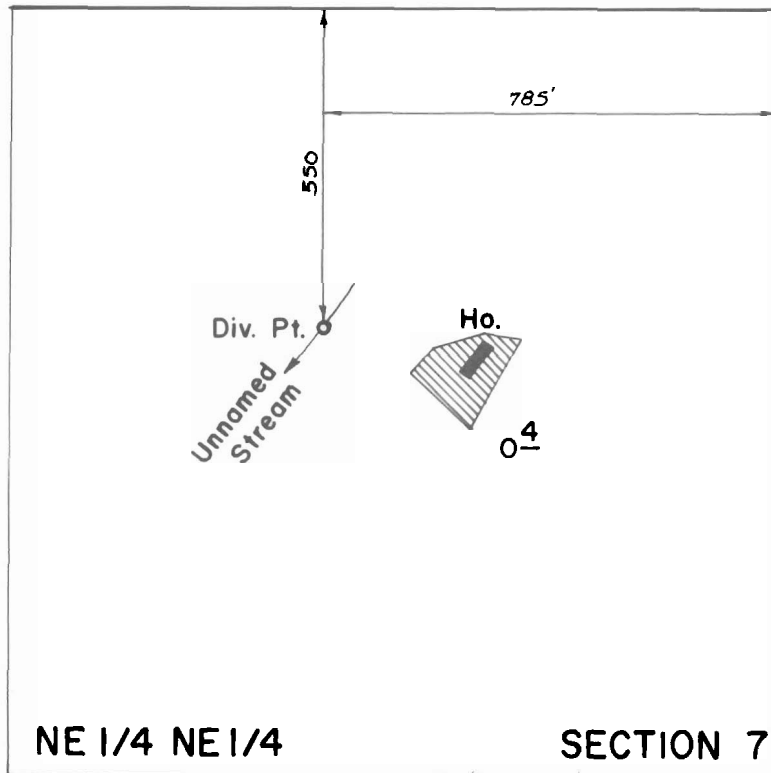

1" = 330'

FINAL PROOF SURVEY
UNDER

Application No. 49588 Permit No. 37211
IN NAME OF

DARYL C. ROBISON

Surveyed July 22 1976, by D. Norby