


T.28S., R.13&14W., W.M.

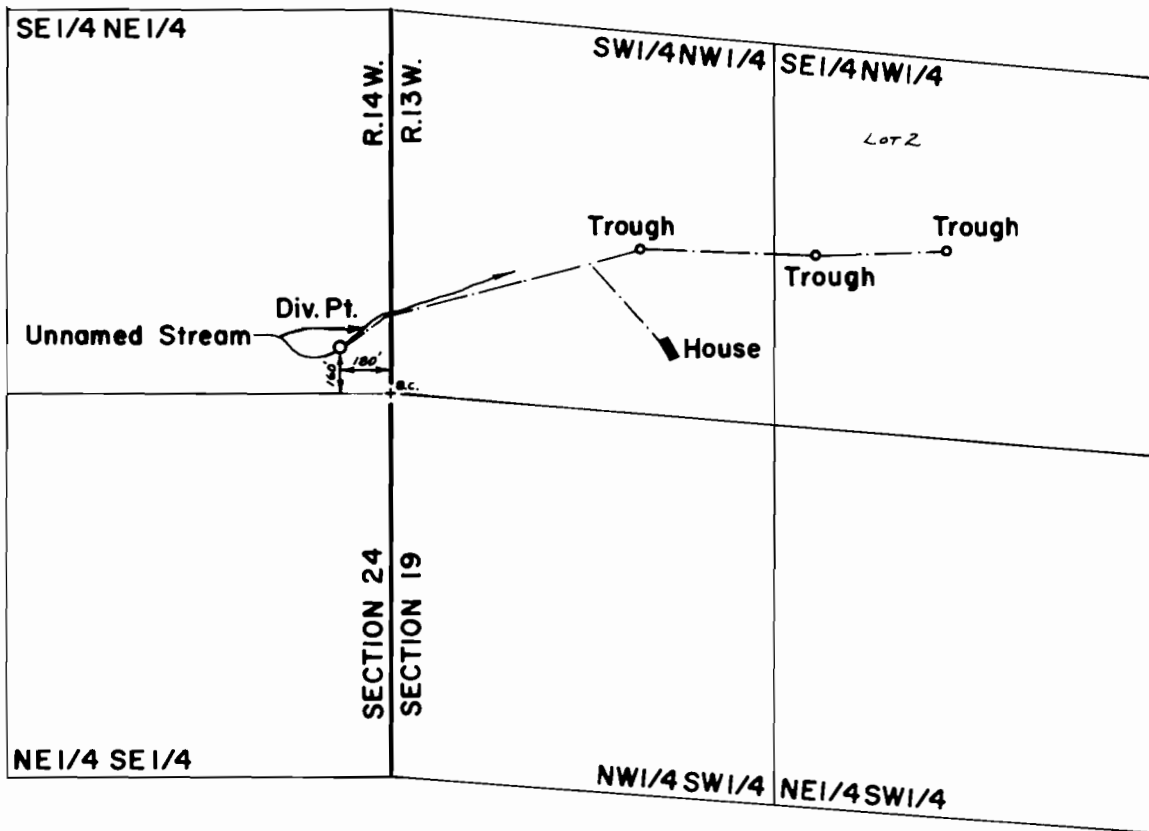

Scale: 1" = 660'

FINAL PROOF SURVEY UNDER

Application No. 50005 53775 Permit No. 37922 40155
IN NAME OF

TOM L. McCULLOCH

Surveyed July 19 1976, by D. Norby