


T.27S., R.12W., W.M.

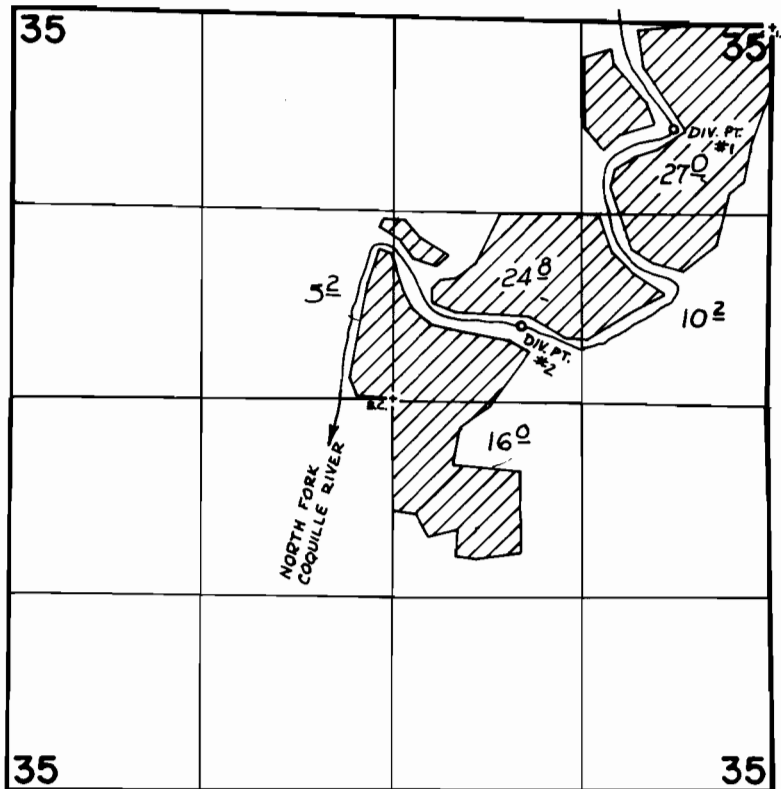

DIV. PT. LOC: *1 - 720' S & 670' W FROM NE COR. SEC. 35
*2 - 520' N & 880' E FROM CENTER SEC. 35

FINAL PROOF SURVEY
UNDER

Application No. 50180 Permit No. 37690
IN NAME OF

LEE VALLEY FARMS, INC.

Surveyed July 16 1976, by D. Norby