


T.28 & 29 S. R. 12 W. W.M.

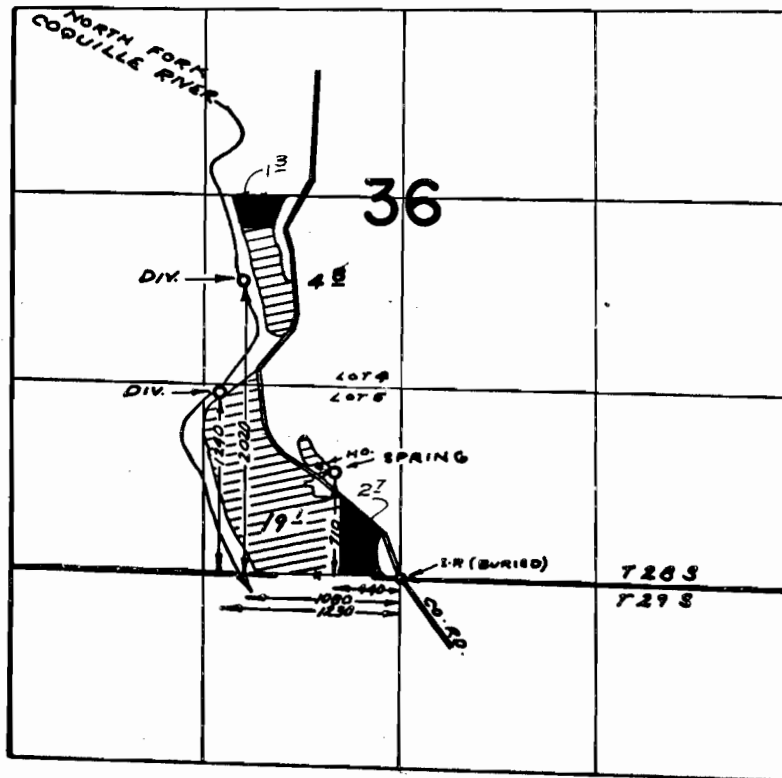

Application map for
[redacted] area not previously allowed

Application No. 39473... Permit No. 29306...
IN NAME OF

.....ZENO BRIGHT.....

Surveyed JULY 17, 1972, by R. MUCKEN

Application No. 51159
Permit No. 38665

RECEIVED

AUG 28 1973
STATE ENGINEER
SALEM, OREGON