


T.28S., R.13W., W.M.

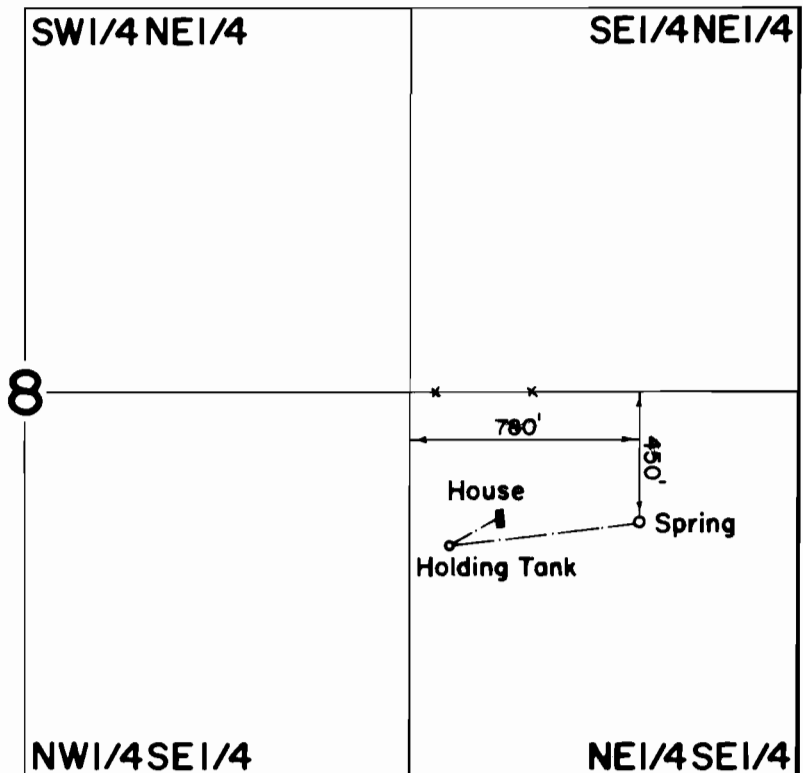

Scale: 1" = 660'

FINAL PROOF SURVEY
UNDER

Application No. 51184 Permit No. 38679
IN NAME OF

JOHN O. DALRYMPLE

Surveyed July 20 1976, by D. Norby