


T.28S., R.13W., W.M.

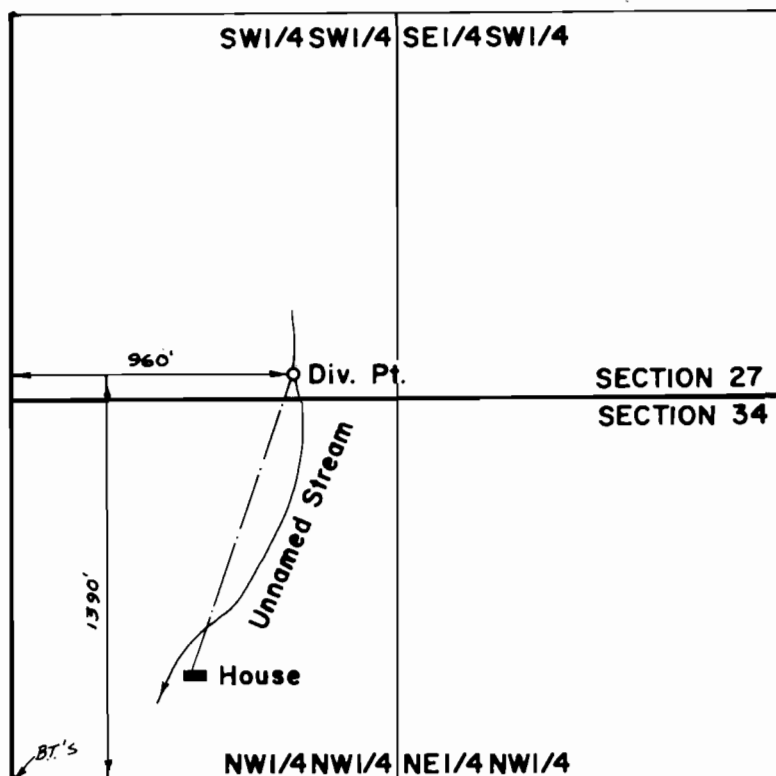

Scale: 1" = 660'

**FINAL PROOF SURVEY**  
UNDER

Application No. 51203 Permit No. 38691  
IN NAME OF

KENNETH E. JOHNSON

Surveyed July 21 1976, by D. Norby