


T.26S., R.12W., W.M.

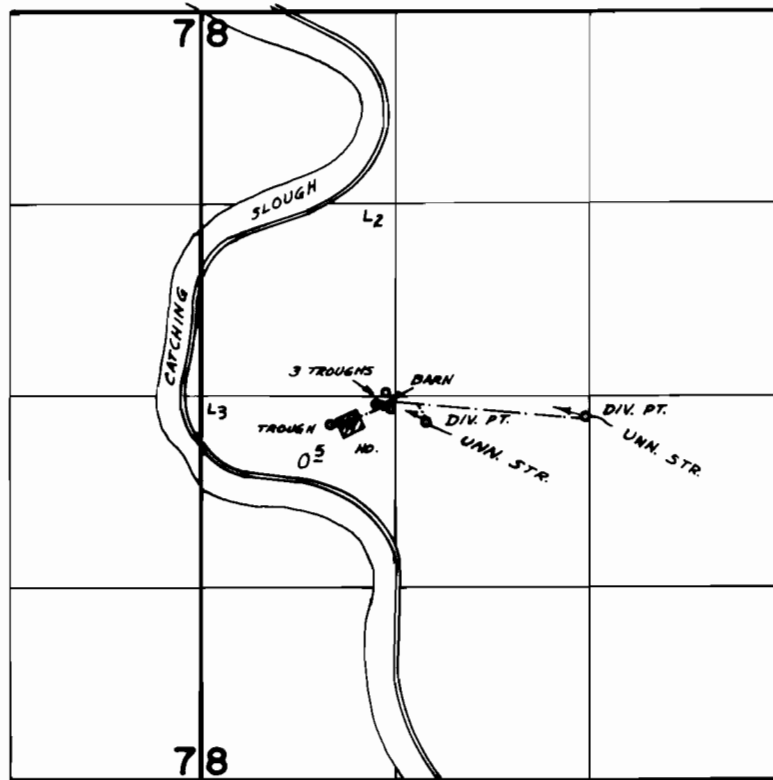

DIV. PTS. LOC: WEST-180' S & 1530' E; EAST-140' S & 2620' E BOTH FROM W 1/4 COR SEC. 8

FINAL PROOF SURVEY
UNDER

Application No. 51204 Permit No. 38808
IN NAME OF

ROLAND J. DUBISAR

Surveyed July 14 1976, by D. Norby