


T.28S., R.13&14W., W.M.

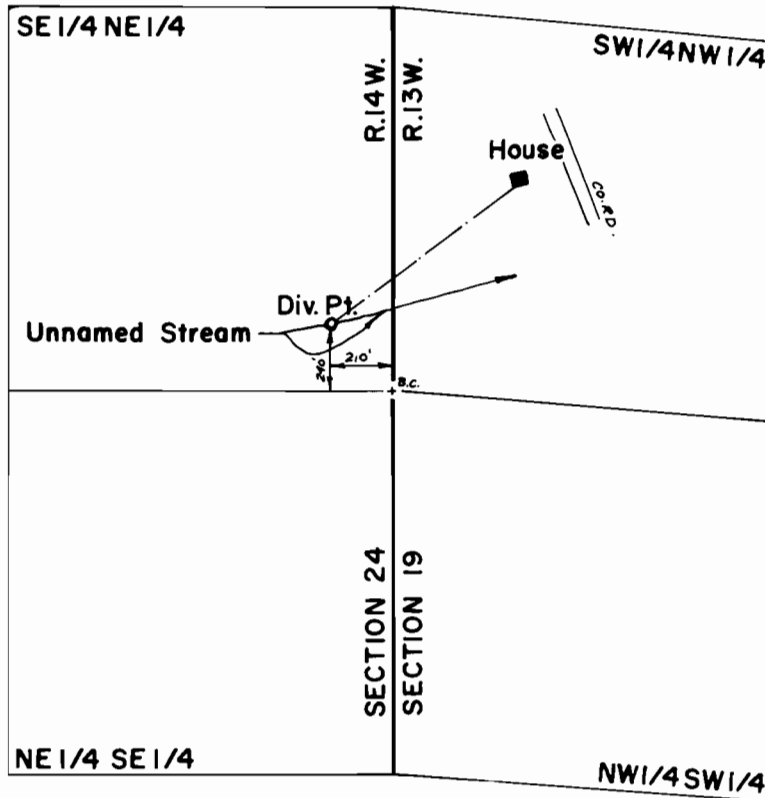

Scale: 1" = 660'

FINAL PROOF SURVEY
UNDER

Application No. 50173 Permit No. 37921
IN NAME OF

ROY C. BLOHM JR.

Surveyed July 19 1976, by D. Norby