


T. 33 S. R. 14 W. W.M.

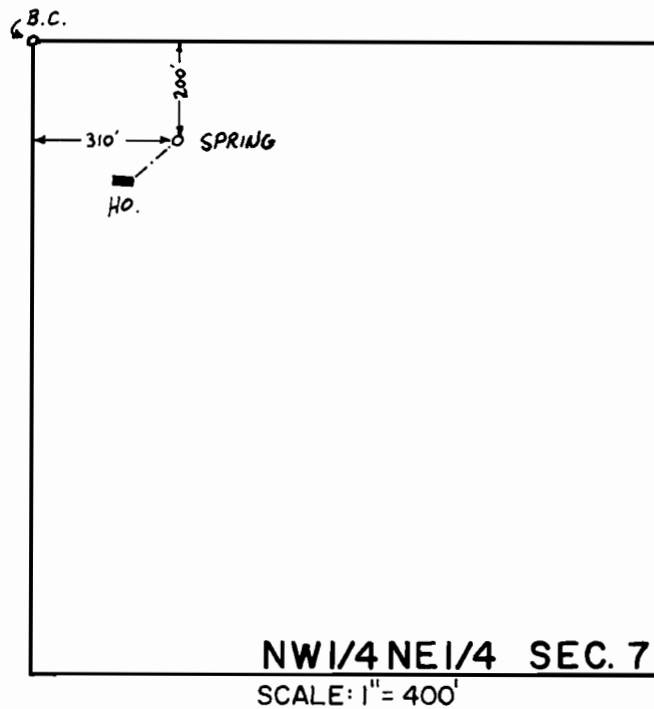

FINAL PROOF SURVEY
UNDER

Application No. 49267... Permit No. 36531.....
IN NAME OF

MONTE W. & SANDRA K. NEDROW

Surveyed OCT. 23, 1976., by L. E. GOULD.....