


T.17S.,R.11&12E.,W.M.

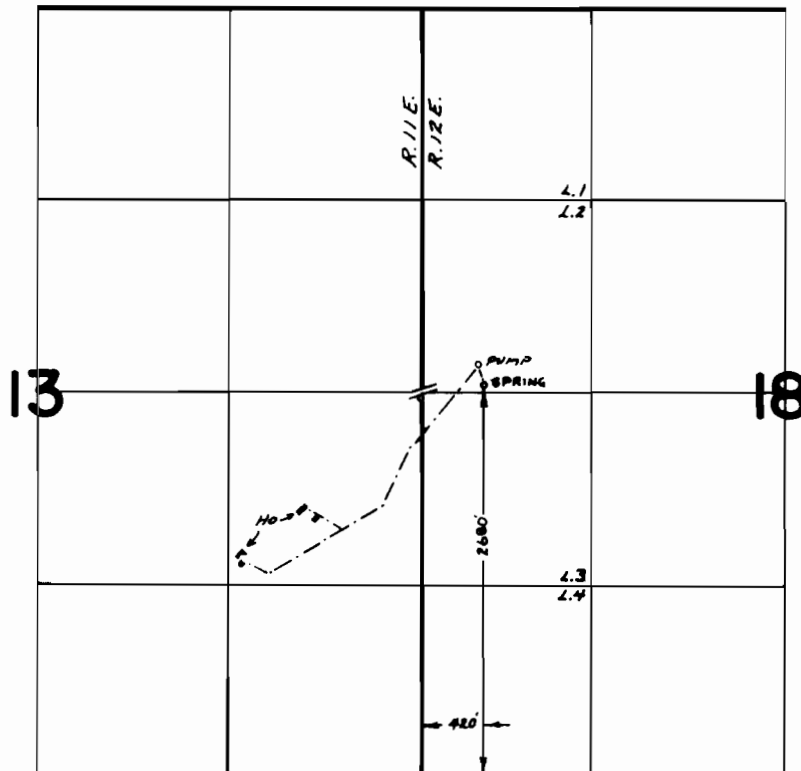

FINAL PROOF SURVEY
UNDER

Application No. 48632 Permit No. 36478
IN NAME OF

ESTATE OF RALPH H. CAKE

Surveyed MAY 12 1976, by L. TOLL