


T.28S.,R.8W.,W.M.

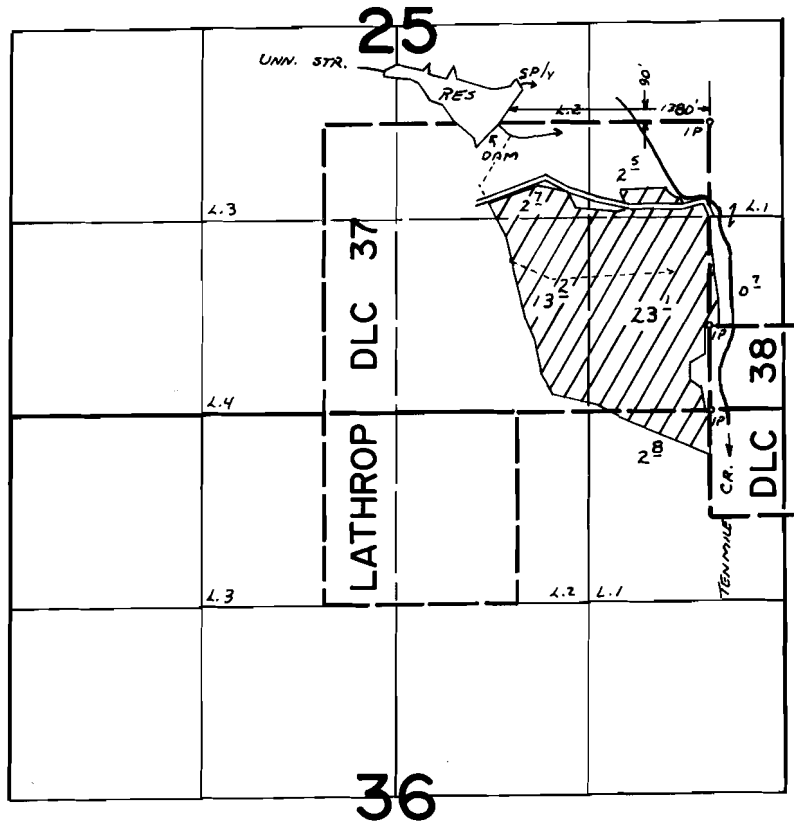

FINAL PROOF SURVEY
UNDER

R-43948 R-5427
Application No. 43949 Permit No. 34136
IN NAME OF

EDWARD J. WAGEMAN

Surveyed JULY 23 1975, by L. E. GOULD