


T.26S., R.2E., W.M.

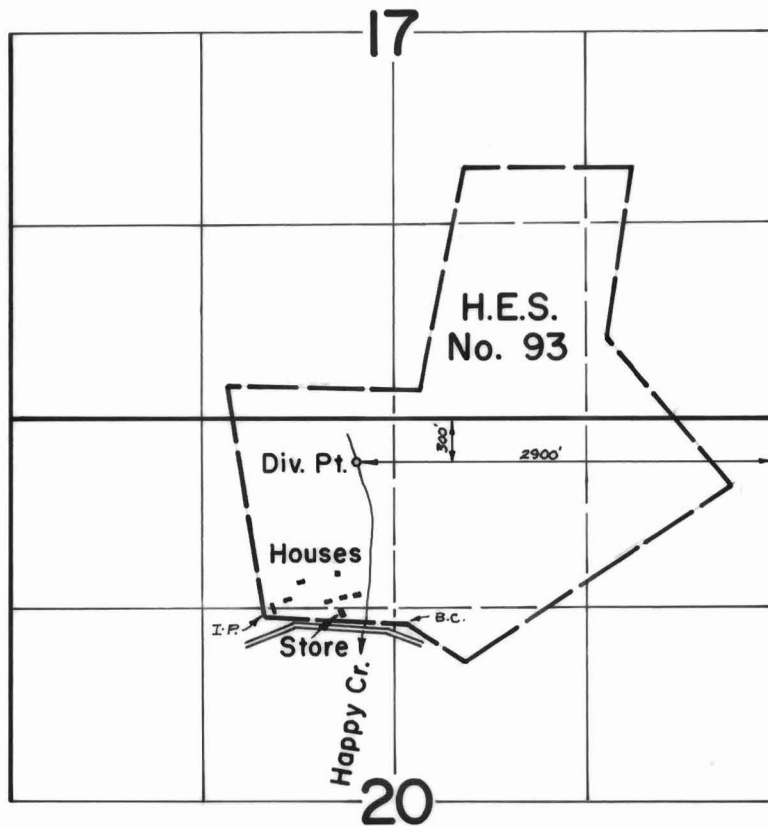

FINAL PROOF SURVEY
UNDER

Application No. 45522 Permit No. 33970
IN NAME OF

DONALD H. PANKEY

Surveyed Aug. 31 1976, by D. Norby