


T.26S., R.6W., W.M.

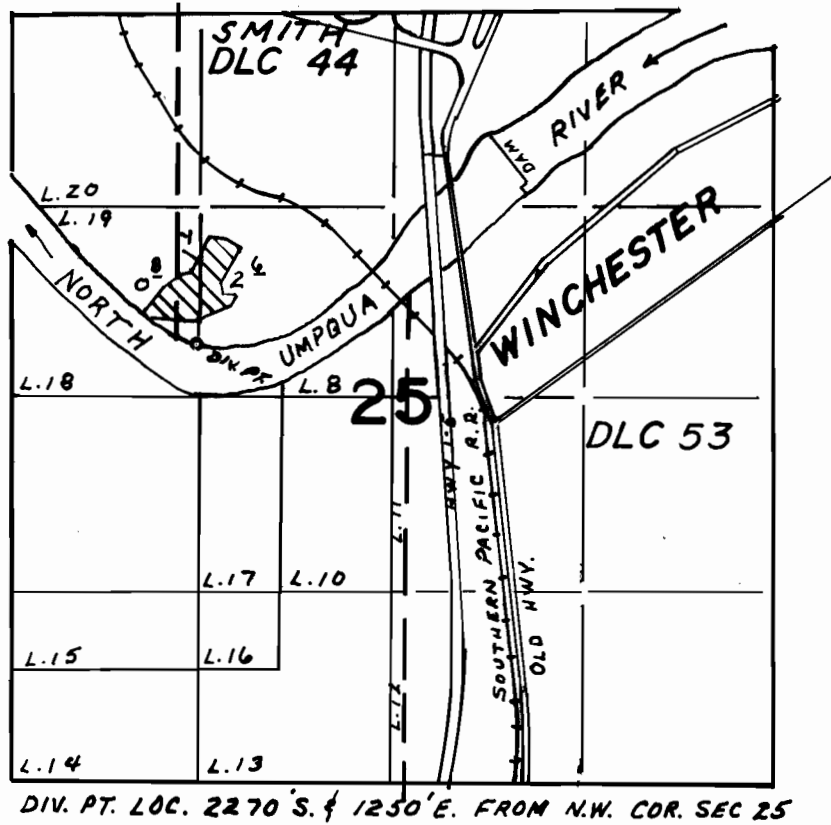

FINAL PROOF SURVEY UNDER

Application No. 45642 Permit No. 34038
IN NAME OF

ROSEBURG ROD & GUN CLUB

Surveyed APR 5 1976, by L.H. NUNN