


# T.23 S.R.8 W.W.M.

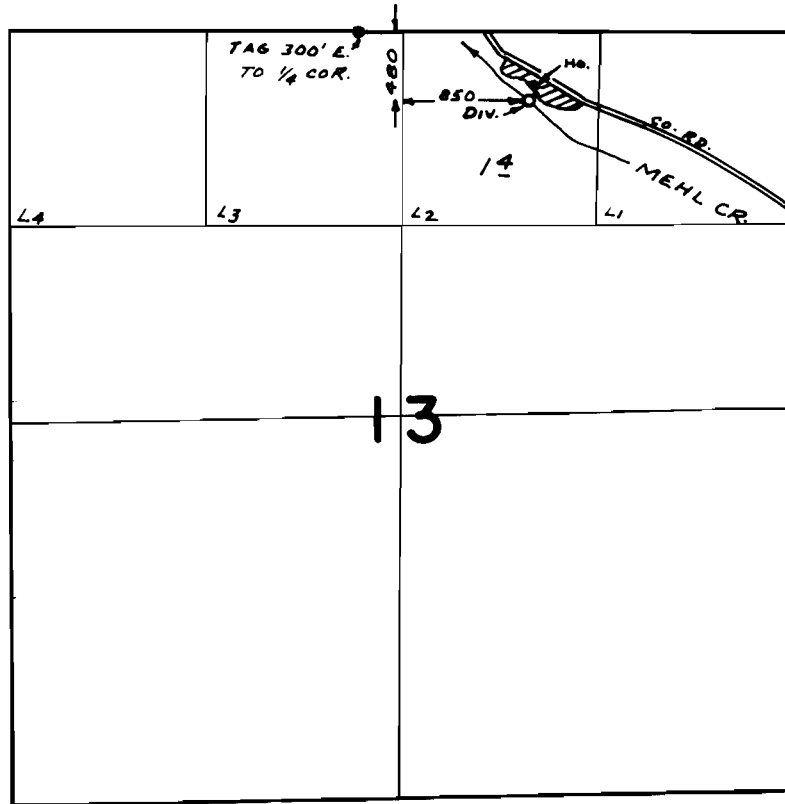

## FINAL PROOF SURVEY UNDER

Application No. 46577 Permit No. 34809  
IN NAME OF

WILLIAM E. LUCILLE P. COOLEY

Surveyed MAY 12, 1976, by R. MUCKEN