


T.29S. R.5W. W.M.

SEC. 5

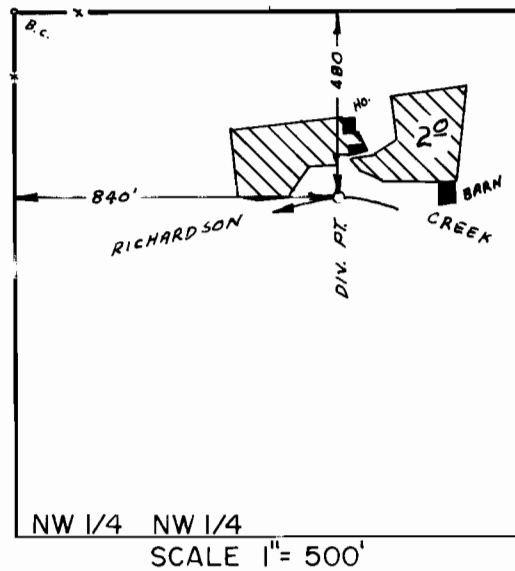

FINAL PROOF SURVEY
UNDER

Application No. 48513 Permit No. 36399
IN NAME OF

ESTATE OF LANE HENRY NORRIS

Surveyed OCT. 8 1976, by L.H. NUNN