


T.26S., R.3W., W.M.

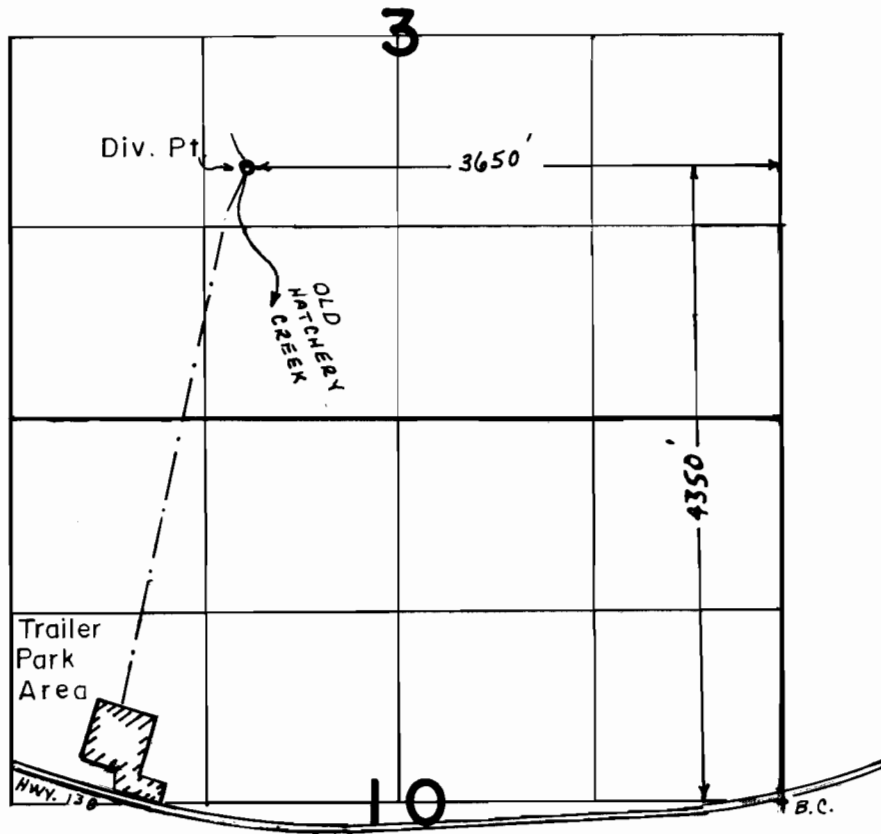

FINAL PROOF SURVEY UNDER

Application No. 50268.. Permit No. 38087..
IN NAME OF

D. B. RANCH

Surveyed April 7, 1976, by D. NORBY