


T.26S., R.3W., W.M.

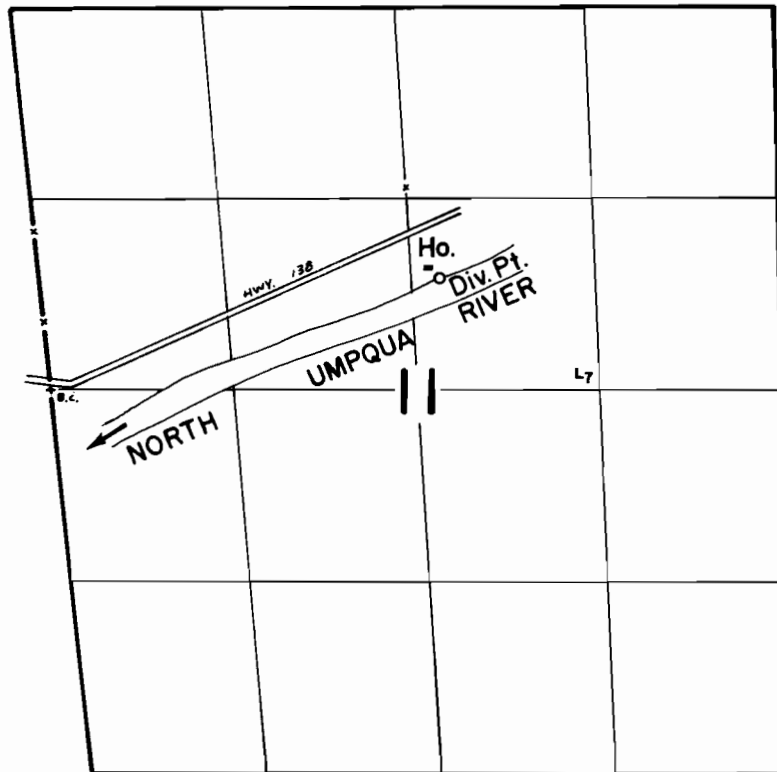

DIV. PT. LOC: 770' N & 2660' E FROM W 1/4 COR. SEC. 11

FINAL PROOF SURVEY
UNDER

Application No. 50479 Permit No. 38121
IN NAME OF

James S. & Jeanne E. Wallace

Surveyed April 7 1976, by D. Norby