


T.28 & 29S. R.6W. W.M.

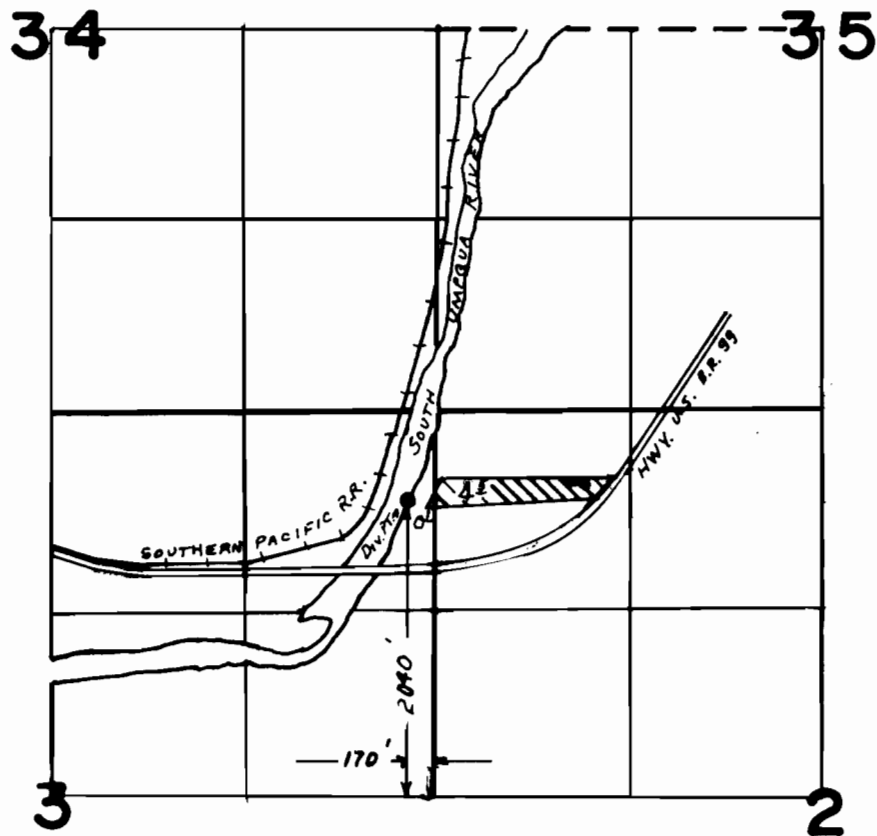

FINAL PROOF SURVEY
UNDER

Application No. 51281 Permit No. 38725
IN NAME OF

.....**EARL S. EPPS**.....

Surveyed OCT. 6, 1976, by L.H. NUNN.....