


T.25S., R. 4 W., W.M.

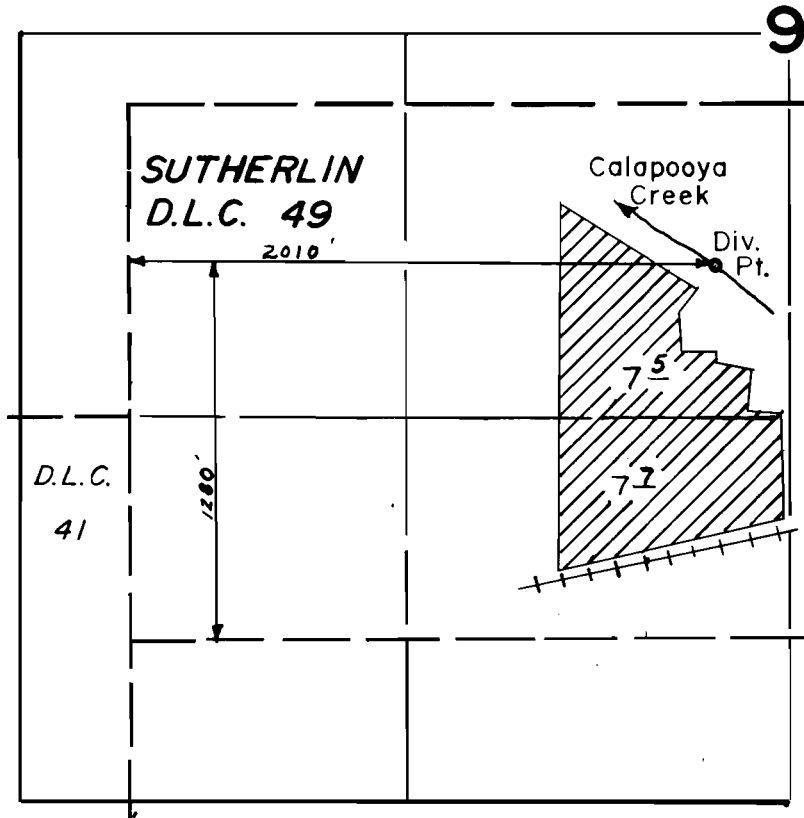

Scale: 1" = 660'

FINAL PROOF SURVEY UNDER

Application No. 52645... Permit No. 39676..
IN NAME OF

.....ARTHUR T. BOHME.....

Surveyed JULY 26, 1976, by D. NORBY.....