


T.26S., R.6W., W.M.

SEC. 27

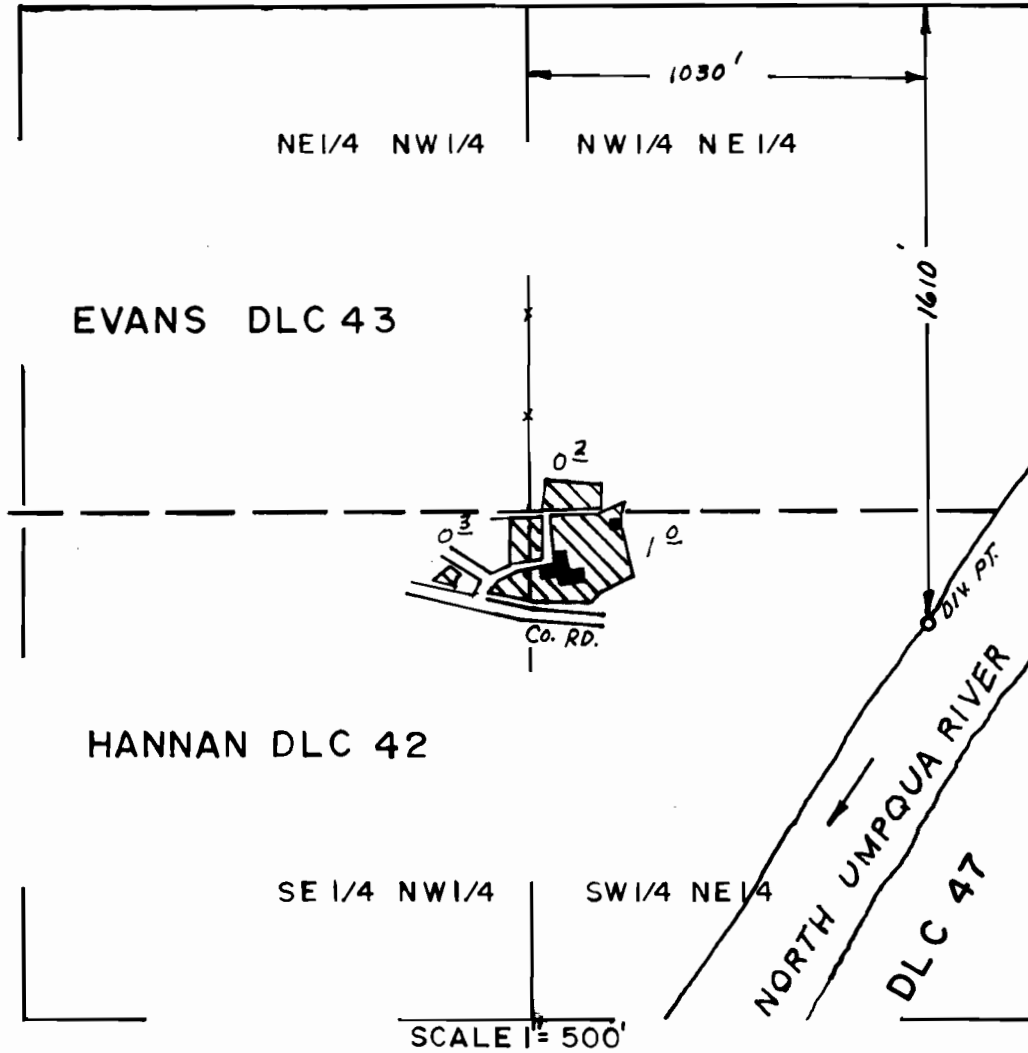

FINAL PROOF SURVEY
UNDER

Application No. 52688... Permit No. 39692.
IN NAME OF

.....**CECIL LYNN RILEY**.....

Surveyed **SEPT. 17, 1976**, by **A.H. NUNNY**.....