


T.26S., R.6W., W.M.

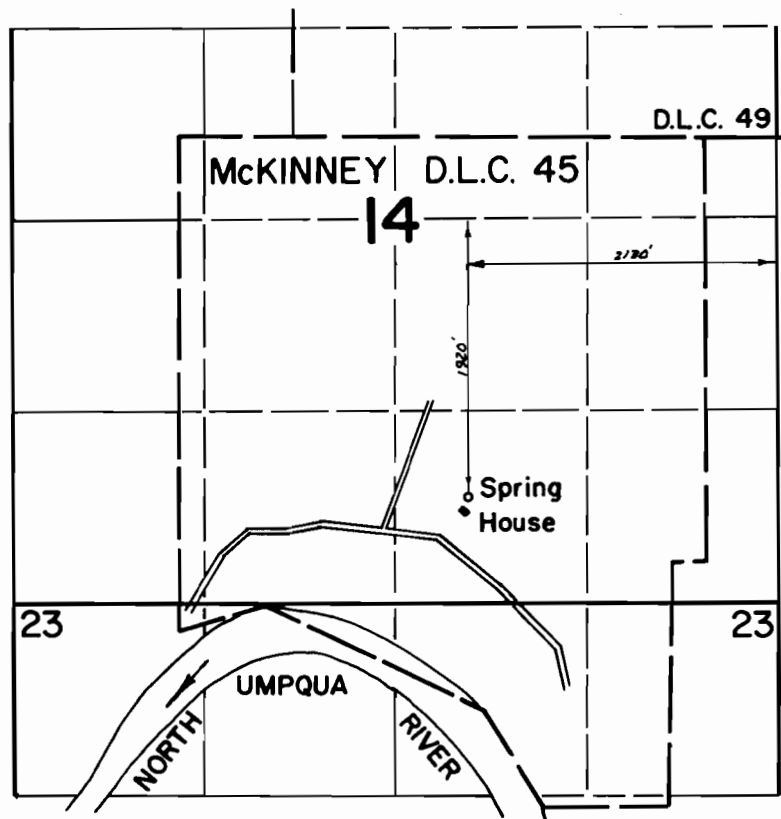

FINAL PROOF SURVEY UNDER

Application No. 52908 Permit No. 39954
IN NAME OF

MICHAEL D. ROARK

Surveyed Aug. 30 1976, by D. Norby