


T.26S., R.6W., W.M.

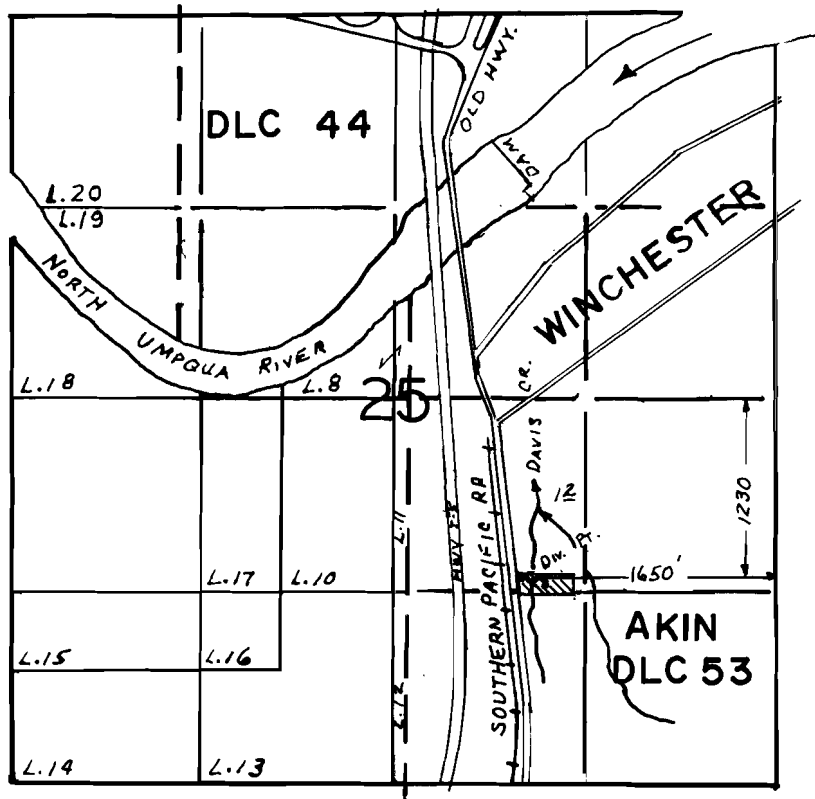

FINAL PROOF SURVEY
UNDER

Application No. 53528. Permit No. 40064.
IN NAME OF

LEROY SEIBOLD

Surveyed AUG. 20. 1976, by L. H. NUNN