


T.26S., R.6W., W.M.

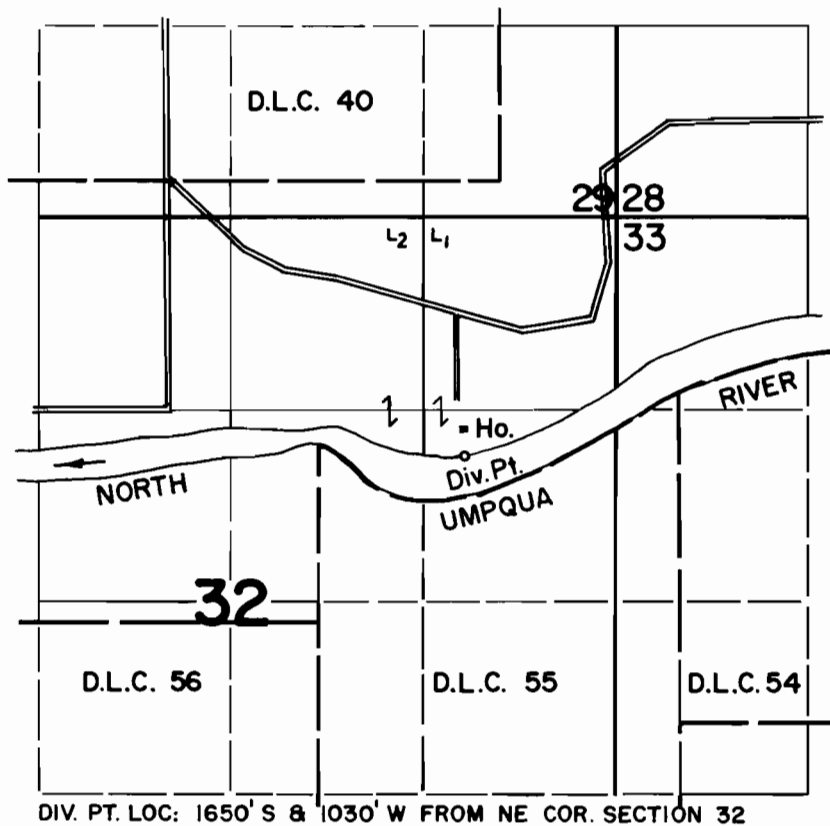

FINAL PROOF SURVEY UNDER

Application No. 53853 Permit No. 40190
IN NAME OF

ROBERT ALLAN BURZYNSKI

Surveyed Aug. 30 1976, by D. Norby