


# T.27S., R.29E., W.M.

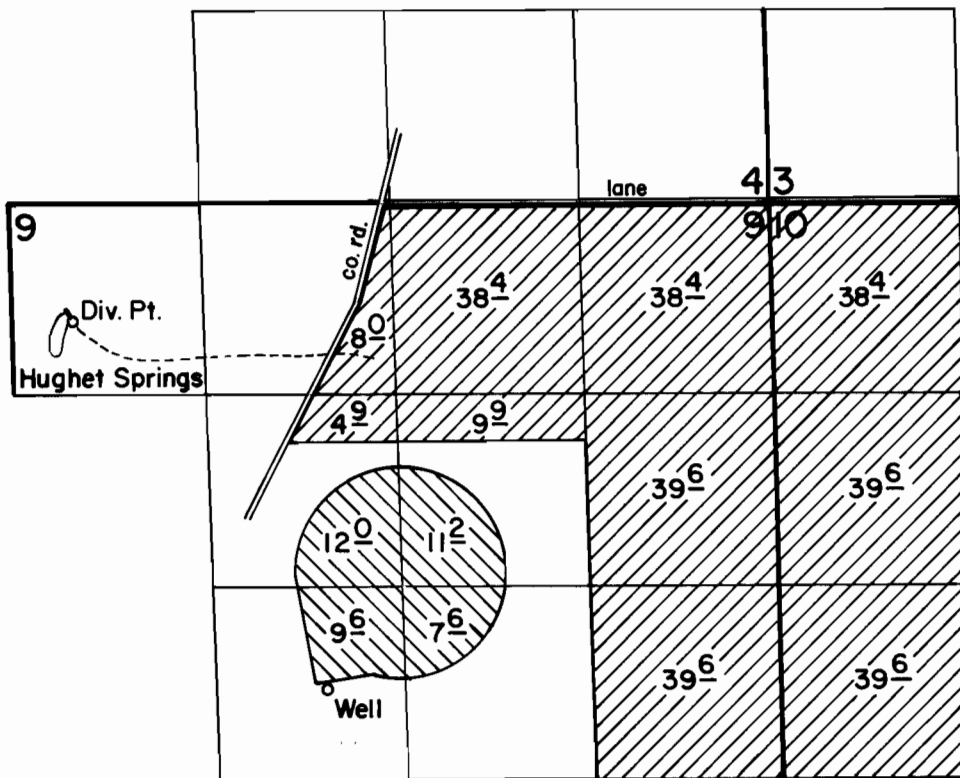

DIV. PT. LOC: SPR.-810' S & 2210' W; Well-3330' S & 540' W both from N 1/4 cor. sec. 9

 Permit 29703  
 Permit G-3202

## FINAL PROOF SURVEY UNDER

Application No. 39905 G-3414 Permit No. 29703 G-3202  
 IN NAME OF

J. V. MOON & SON

Surveyed April 22, 1976, by D. Norby