


T. 34 S., R. 1 W., W.M.

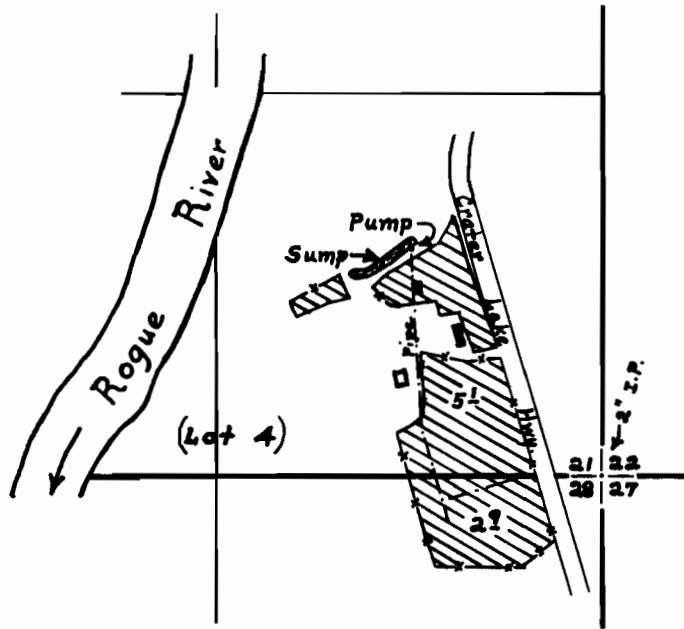

**FINAL PROOF SURVEY**  
UNDER

Application No. G-780 Permit No. G-679  
IN NAME OF

James F. Johnson

Surveyed Mar. 8 1962, by D. A. Hendrix

Scale: 8" = 1 mile