


T.39S.,R.5W.,W.M.

SEC. 3

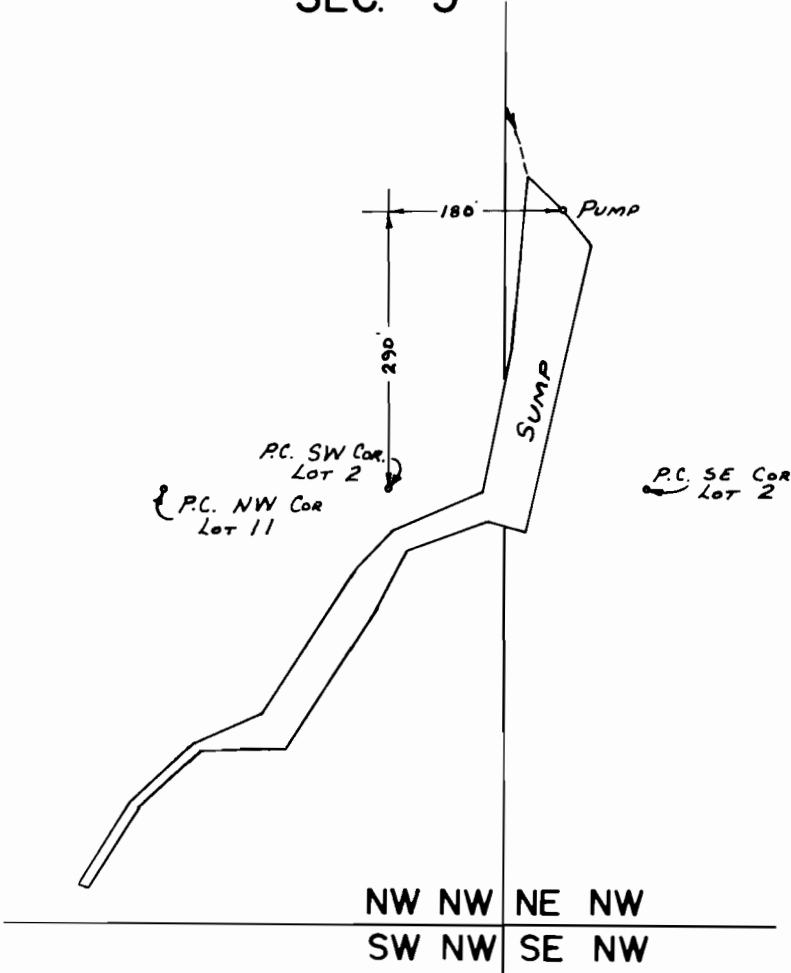

SCALE: 1" = 200'

FINAL PROOF SURVEY
UNDER

Application No. G-5959 Permit No. G-5656
IN NAME OF

CHARLES H. RETZLOFF

Surveyed APRIL 28 1976, by L. TOLL