


T.37S.,R.7W.,W.M.

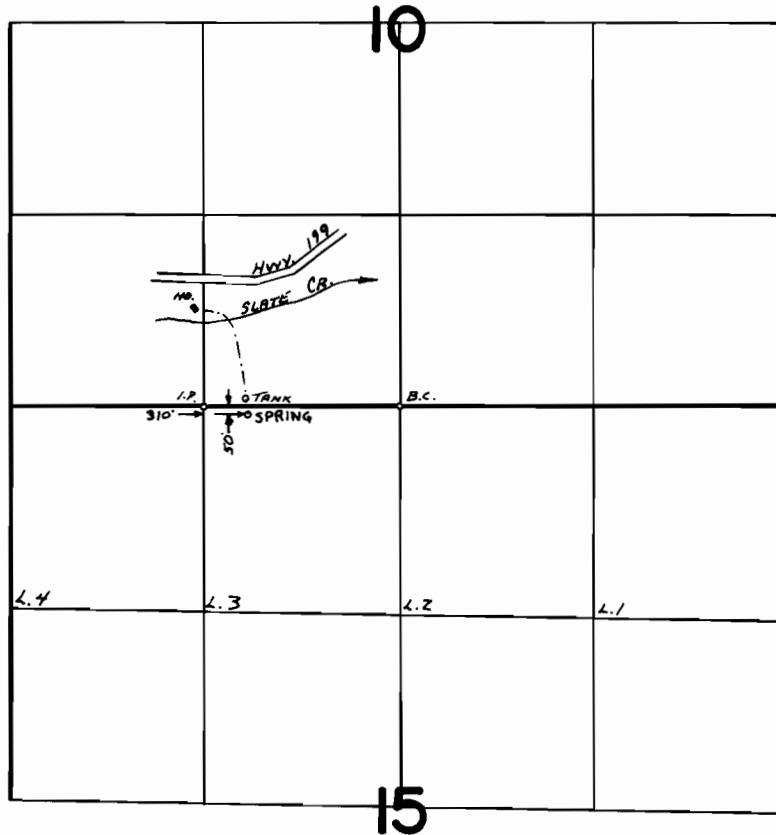

FINAL PROOF SURVEY
UNDER

Application No. 50770 Permit No. 38341
IN NAME OF

WILLIAM E. MALLEY

Surveyed *May 4* 1976, by *L. Toll*