


T.38&39S.,R.6W.,W.M.

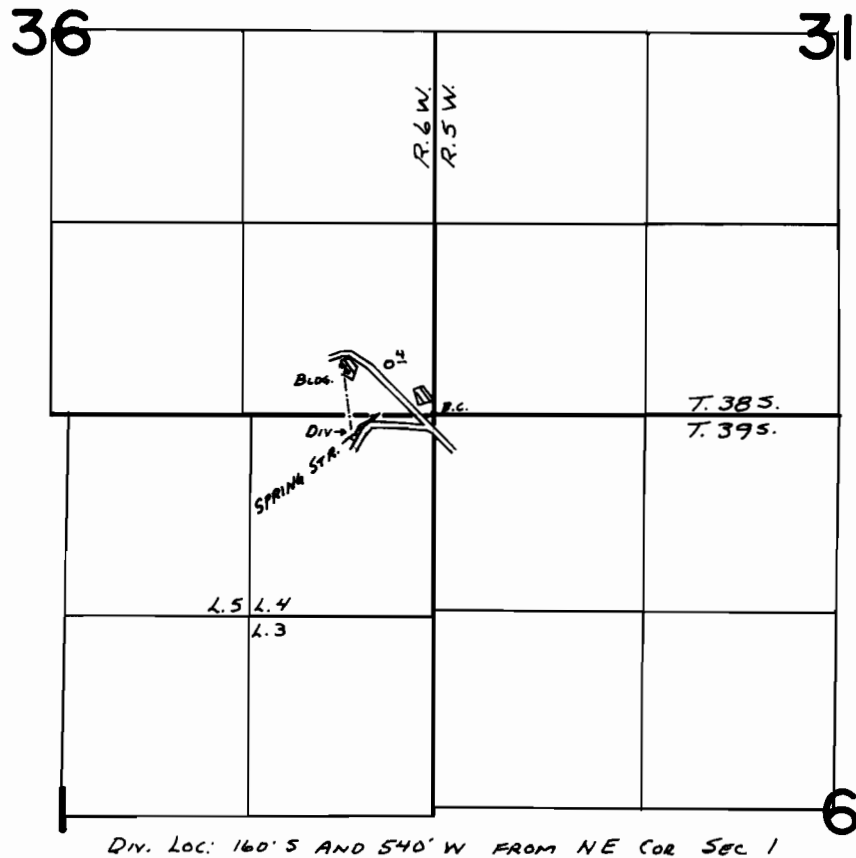

FINAL PROOF SURVEY
UNDER

Application No. 47647 Permit No. 34975
IN NAME OF

MARILYN L. MOORE

Surveyed MAY 3 1976, by L. T. Holt