


3

T. 36S. R. 11E. W.M.

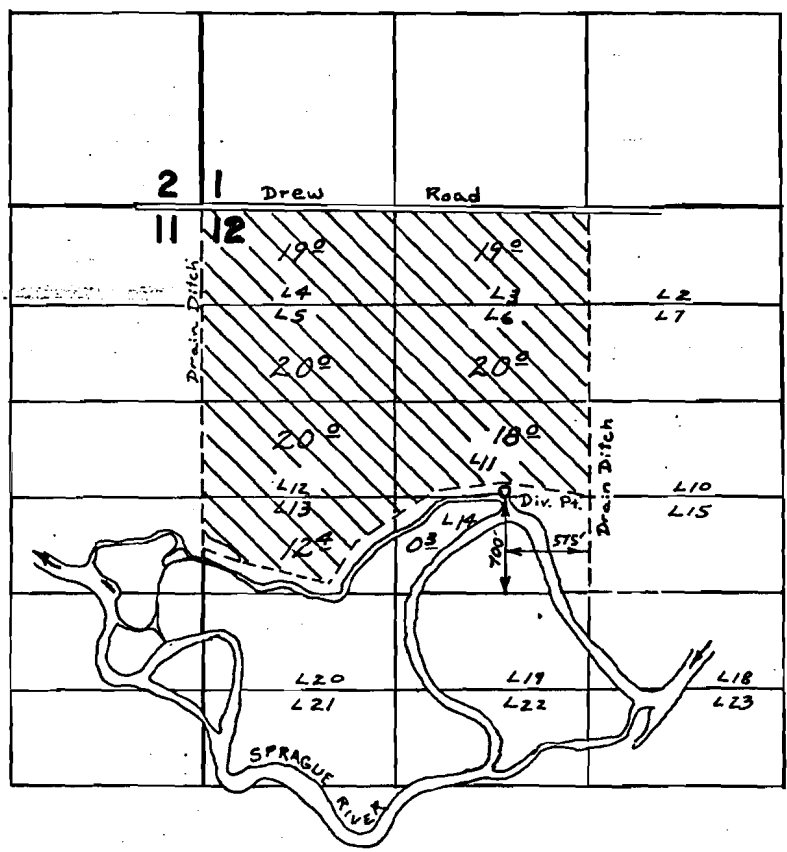

Sprague River

FINAL PROOF SURVEY UNDER

Application No. 46782 Permit No. 34932
IN NAME OF

JOHN and DONNA PERRY

Surveyed AUG. 23. 1977. by D. NORBY