


71-281
23135
46196 RR

T.38S.R.11 1/2 E.W.M.

Bude We : Yuma Valley wells

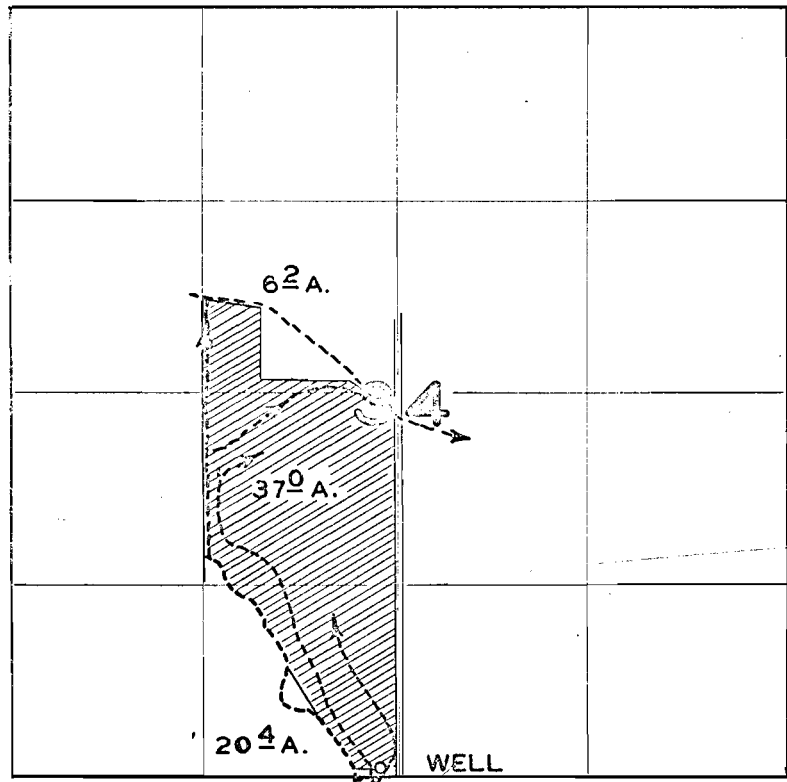

FINAL PROOF SURVEY
UNDER

Application No. U-309.. Permit No. U-281..
IN NAME OF

..... L. J. & ANNE S. HORTON

Surveyed MAY 15, 1951., by H.L. COFFMAN