


U-341

35749
46197

T.27S.R.15E.W.M.

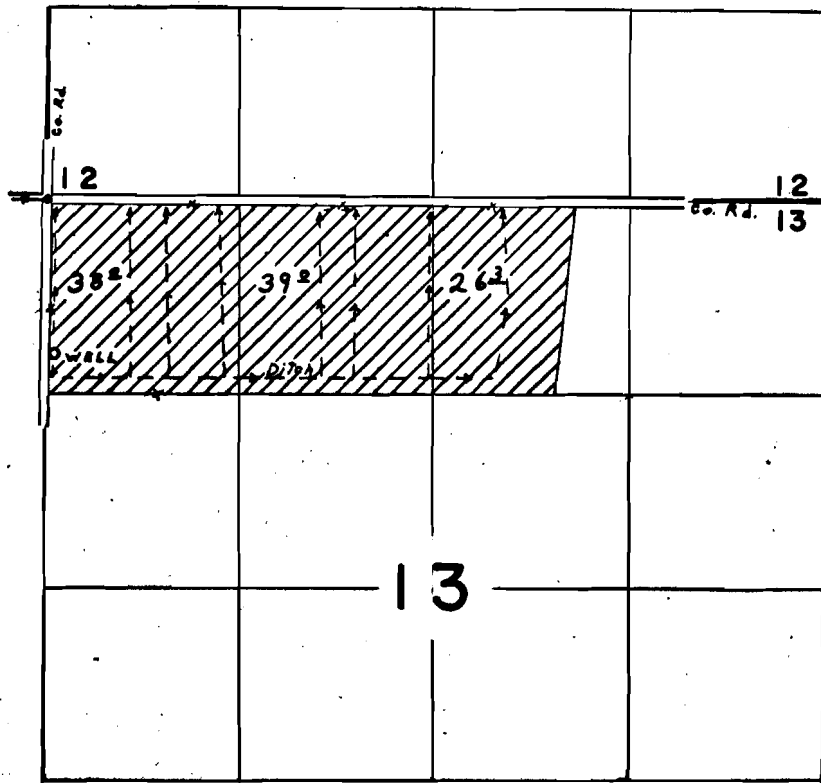

Well located 1040' S. & 60' E. from N.W. Corner Section 13

FINAL PROOF SURVEY
UNDER

Application No. U-354..... Permit No. U-341.....
IN NAME OF

.....JESS MILES.....

Surveyed AUG. 6, 1968, by L.E. GOULD...