


T.16S. R.4W. W.M.

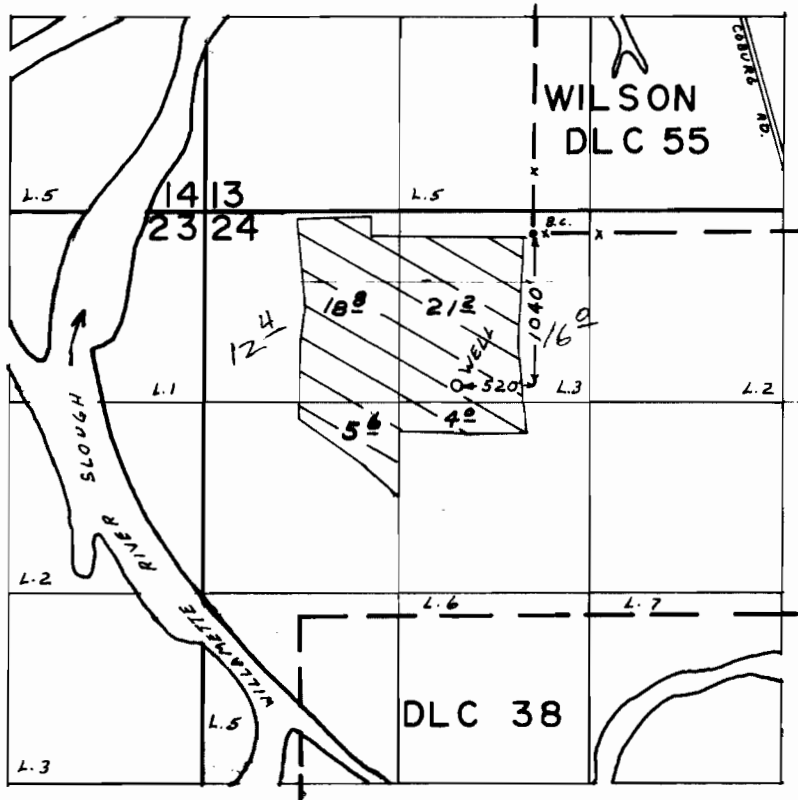

FINAL PROOF SURVEY UNDER

Application No. G-4362. Permit No. G-4114
IN NAME OF

.....EDSEL CHASE.....

Surveyed SEP. 23. 1975., by L.H. NUNN.....