


# T.17S.R.4W.W.M.

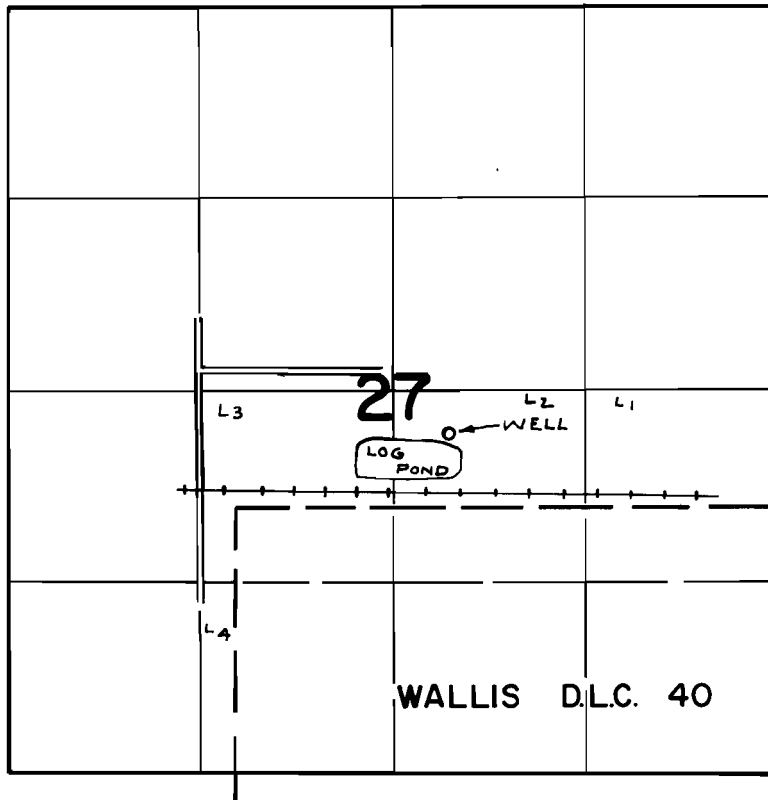

WELL LOC: 350'S. & 2250'W. FROM E  $\frac{1}{4}$  COR. SEC. 27

## FINAL PROOF SURVEY UNDER

Application No. G-6969. Permit No. G-6686  
IN NAME OF

.....B.P.S. ASSOCIATES.....

Surveyed MAY 10, 1978, by L. H. NUNN.