


T.18S.,R.10W.,W.M.

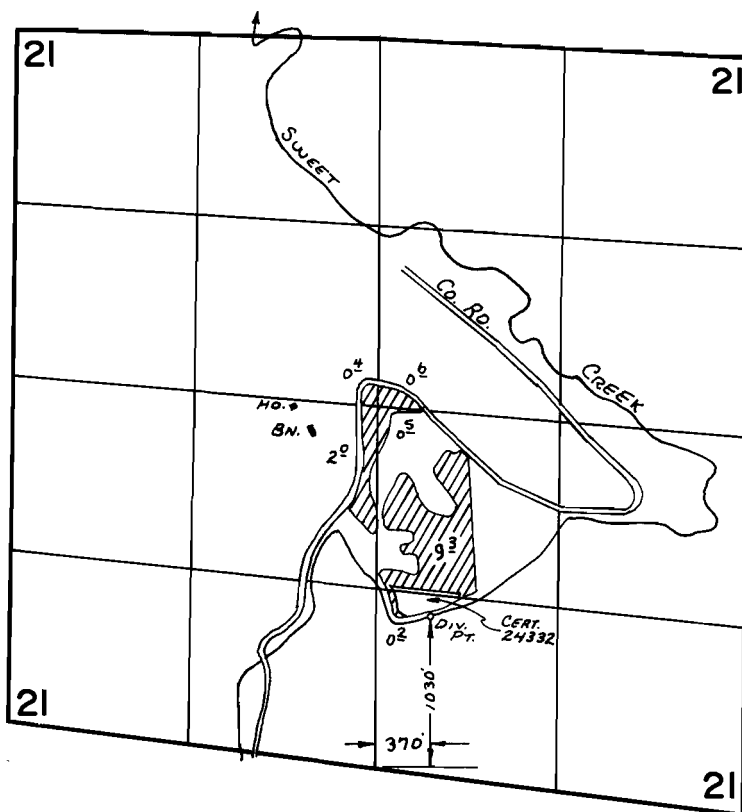

FINAL PROOF SURVEY UNDER

Application No. 44262 Permit No. 33067
IN NAME OF

ALVIN L. DEAN

Surveyed SEPT. 15 1976, by L. T. ...