


# T.18&19S. R.2W. W.M.

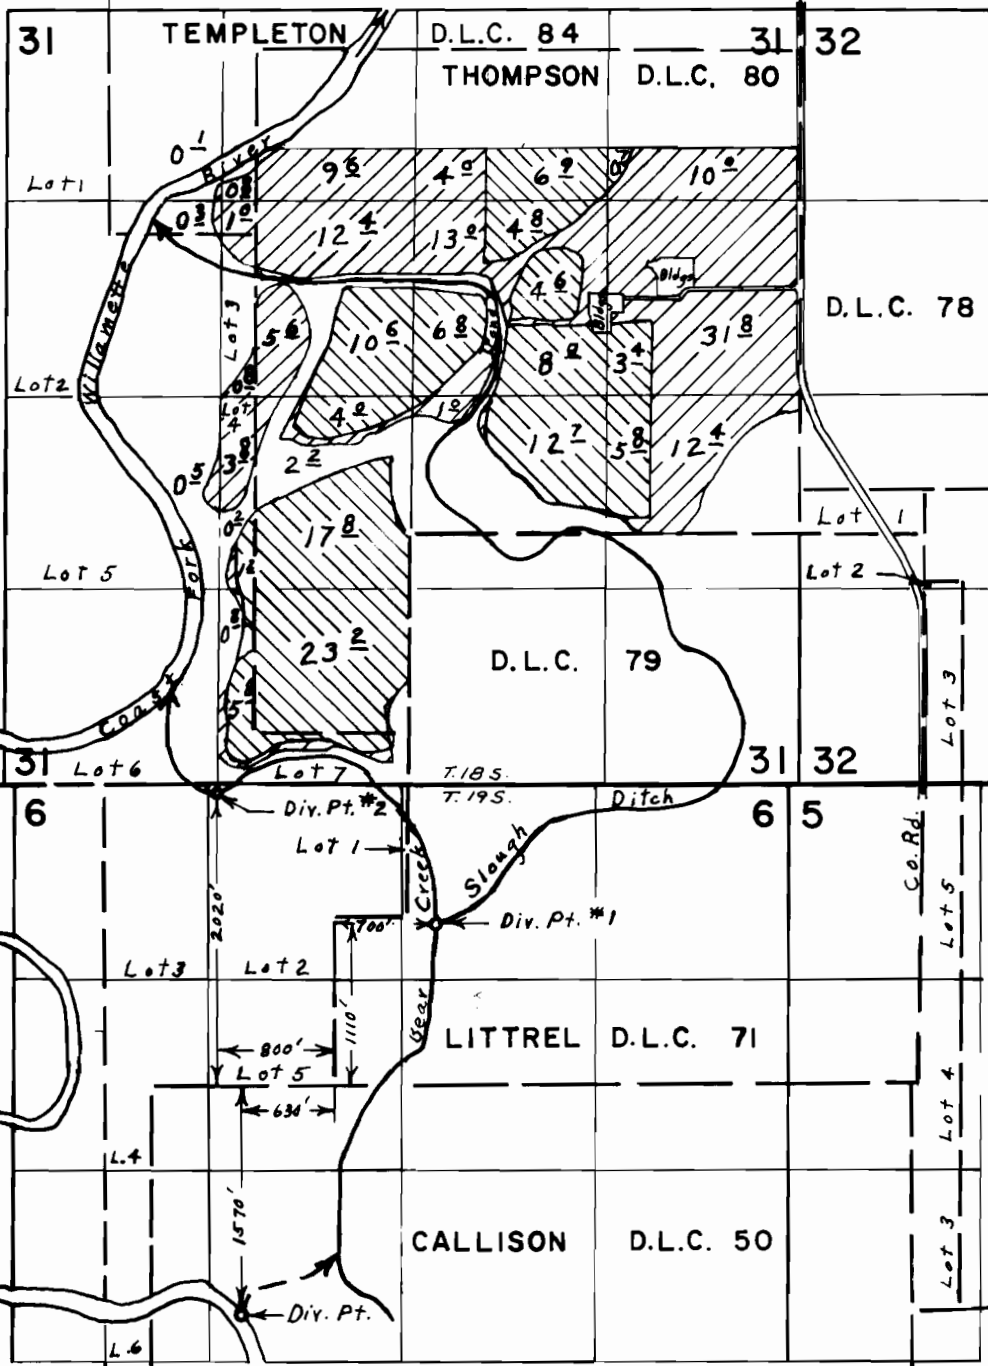

Primary  
Supplemental  
**FINAL PROOF SURVEY**  
UNDER

Application No. 46562 Permit No. 34412  
IN NAME OF

JOHN V. NORTHAM

Surveyed June 23, 1976, by L. E. Gould