


T. 16 S., R. 3 E., W. M.

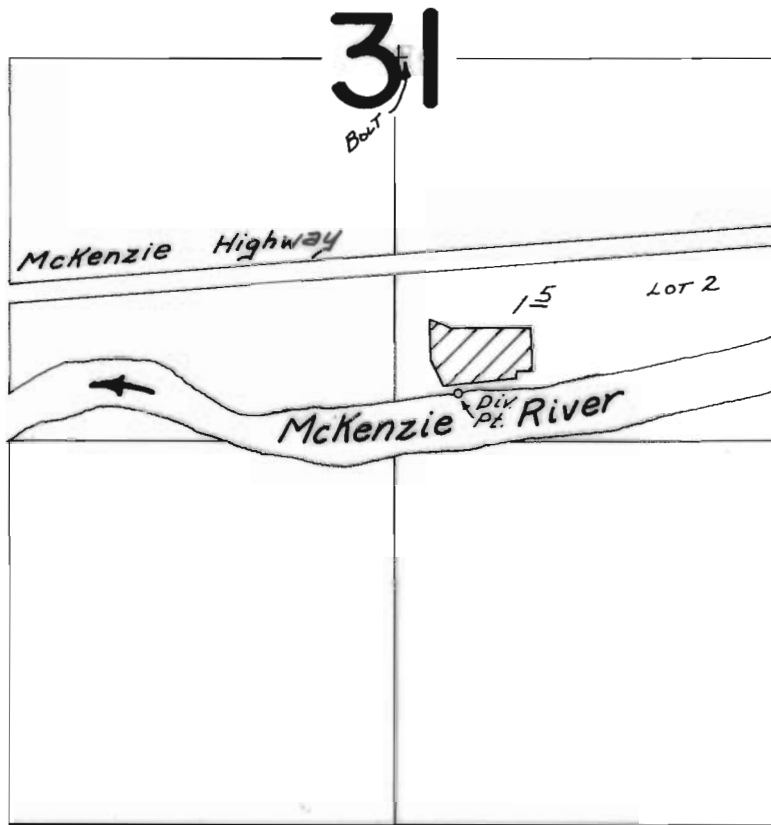

DIV. PT. LOC.: 1150'S. & 220'E. from Ctr. $\frac{1}{4}$ Cor.
Sec. 31

SCALE 1" = 660'

FINAL PROOF SURVEY
UNDER

Application No. 50904 Permit No. 38432
IN NAME OF

Herbert B. Person

Surveyed May 28, 1976, by D.M. Norby

PTS-1976-B *dlb*