


T.21S.,R.3W.,W.M.

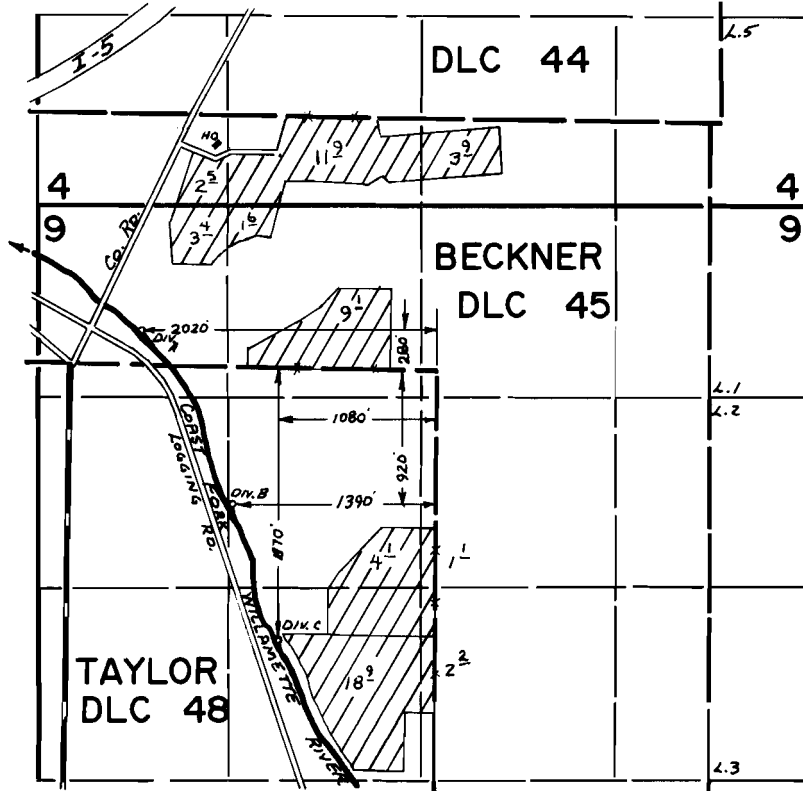

FINAL PROOF SURVEY UNDER

Application No. ...50261... Permit No. ...37887...
IN NAME OF

.....ELDON R. TOBIASSON.....

Surveyed *JUNE 18 1976.*, by *L. TOLL*.....