


T.18S.,R.2W.,W.M.

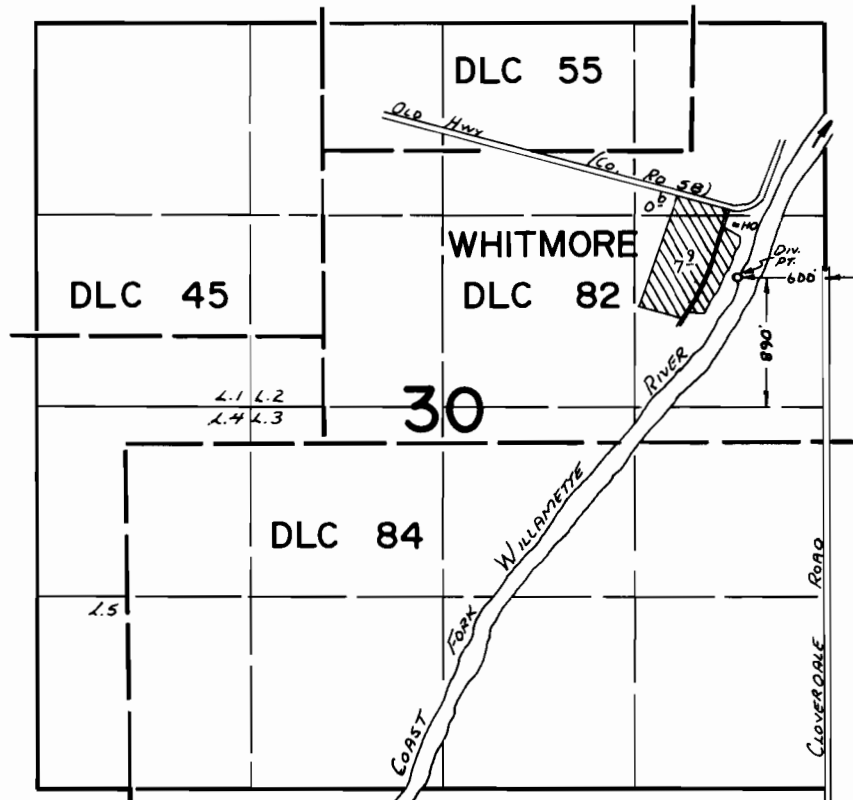

FINAL PROOF SURVEY
UNDER

Application No. 52149 Permit No. 39275
IN NAME OF

DONALD B. MCCARTY

Surveyed JUNE 18, 1976, by L. Toll