


T.20S.,R.3W.,W.M.

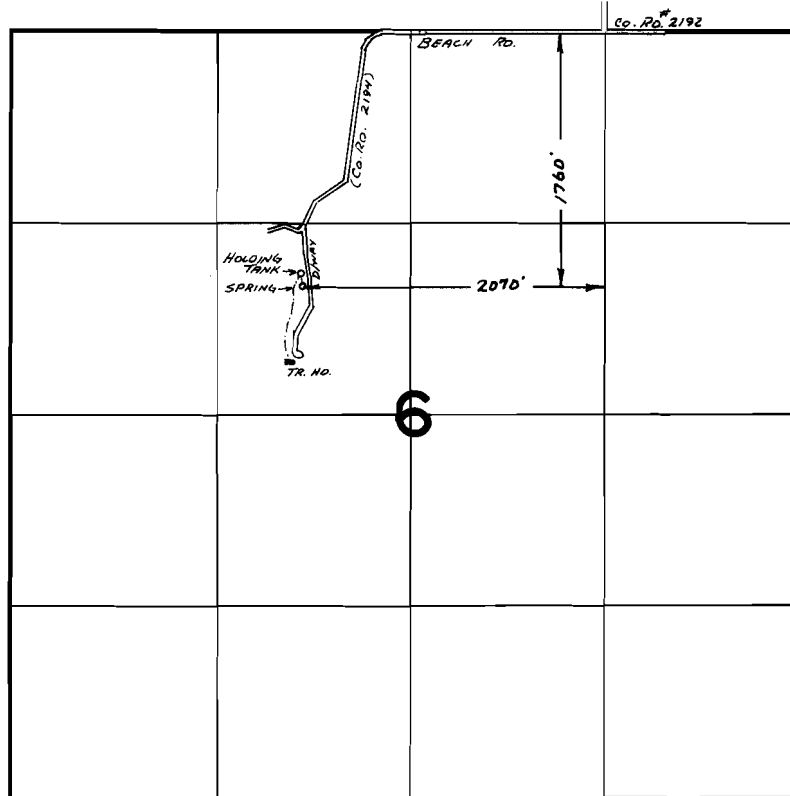

FINAL PROOF SURVEY
UNDER

Application No. 53177 Permit No. 38075
IN NAME OF

RICK L. DURFLINGER

Surveyed JUNE 17 1976, by L. TOLL