


T.15S.R.5W.W.M.

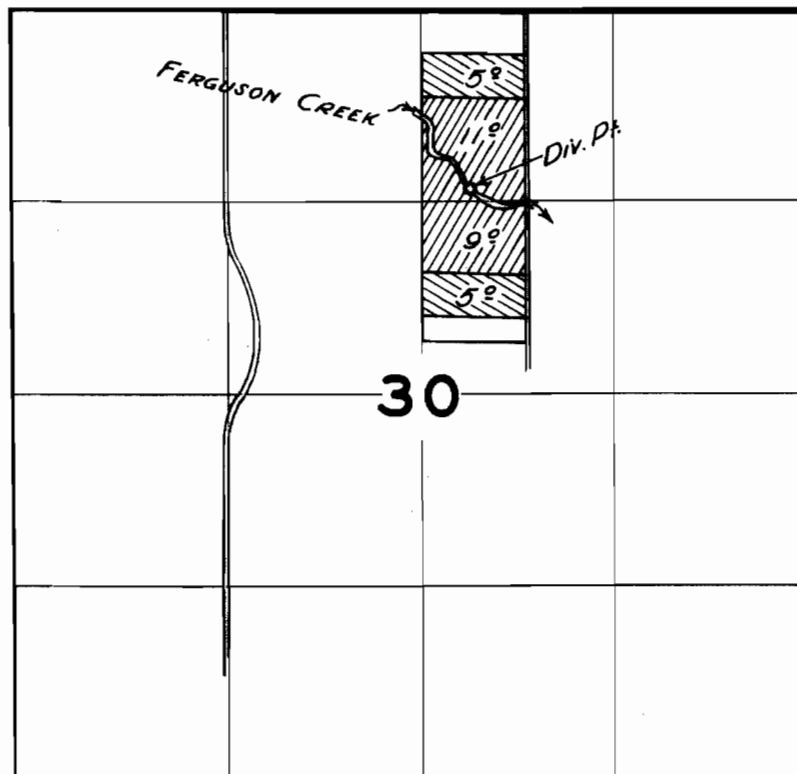

FINAL PROOF SURVEY

UNDER

Application No. 29525 30571 Permit No. 23249 24110

IN NAME OF

THOMAS C. BUCHANAN

Surveyed 16 April 1957, by [Signature]