


T.13S., R.1W., W.M.

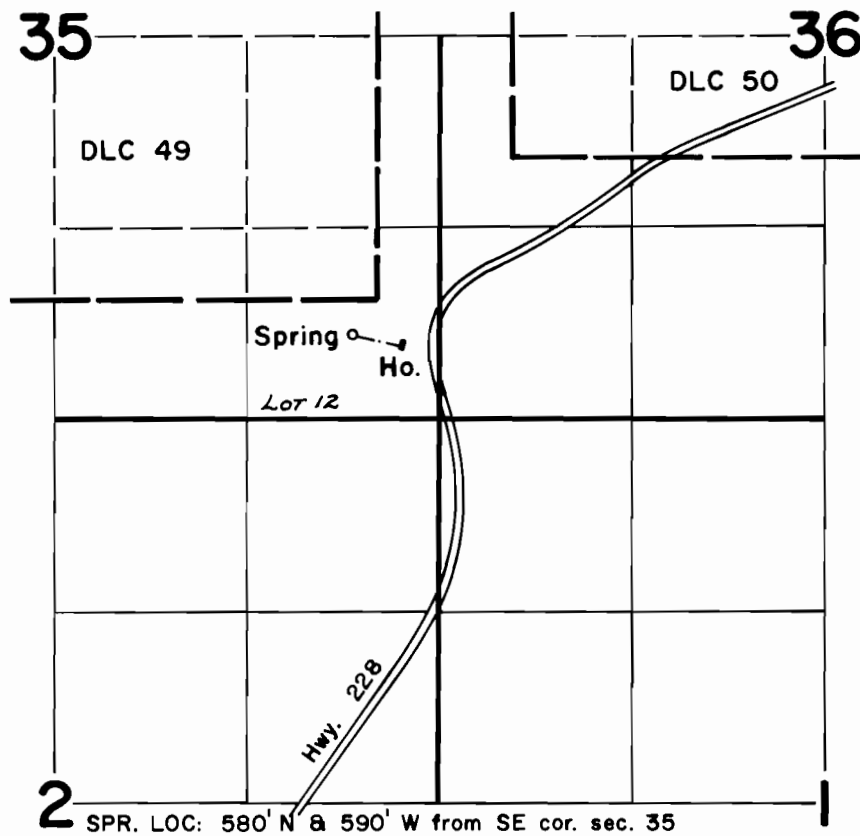

FINAL PROOF SURVEY
UNDER

Application No. 47092 Permit No. 35212
IN NAME OF

DWIGHT L. BROWN

Surveyed July 8 1976, by D. Norby