


T.I.S., R.I.E., W.M.

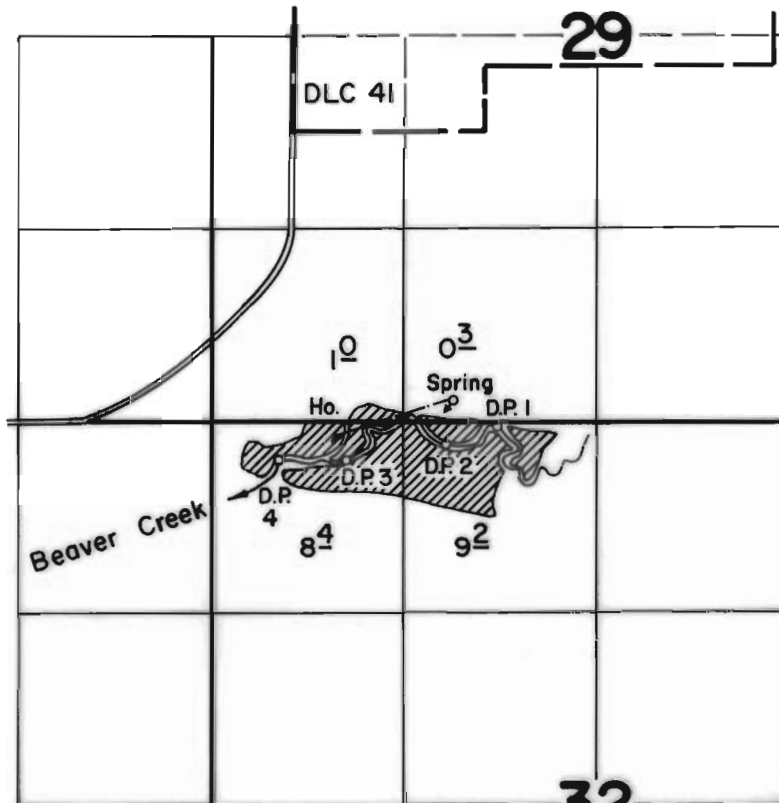

SPR. LOC: 140' N & 1650' E; DIV. PTS. LOC: 1-30' S & 1950' E; 2-160' S & 1600' E; 3-270' S & 910' E; 4-260' S & 460' E all from NW cor. sec. 32

FINAL PROOF SURVEY UNDER

Application No. 48104 Permit No. 35914
IN NAME OF

GORDON WILLIAM BEARD

Surveyed Mar. 29 1976, by D. Norby