


T.18S.R.45E.W.M.

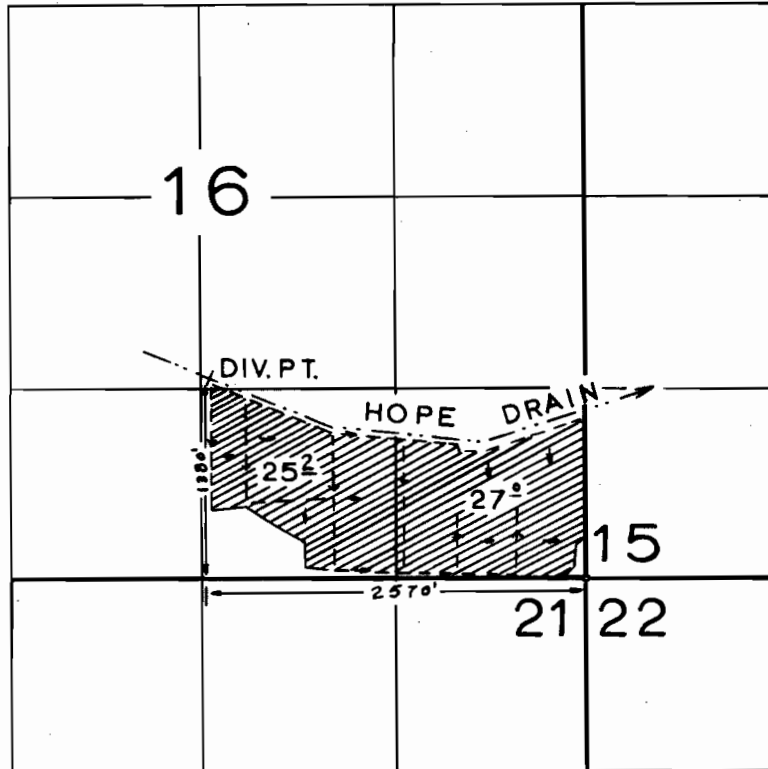

**FINAL PROOF SURVEY**  
UNDER

Application No. 34951 ... Permit No. 27411  
IN NAME OF

REX CARPENTER

Surveyed OCT. 26 1967, by F. ELFERING