


T.6S.,R.2W.,W.M.

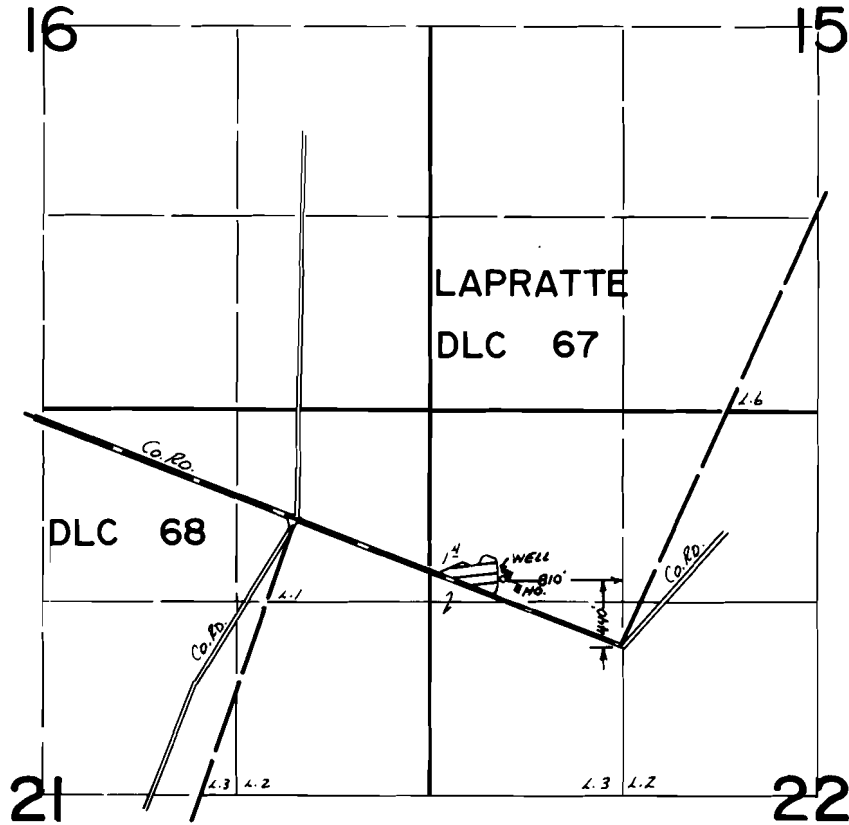

FINAL PROOF SURVEY
UNDER

Application No. G-5374. Permit No. G-5309
IN NAME OF

.....**WILLARD B. AKER**.....

Surveyed *MAY 18, 1976.* by *L. Toll*.....