


T.6S.,R.2W.,W.M.

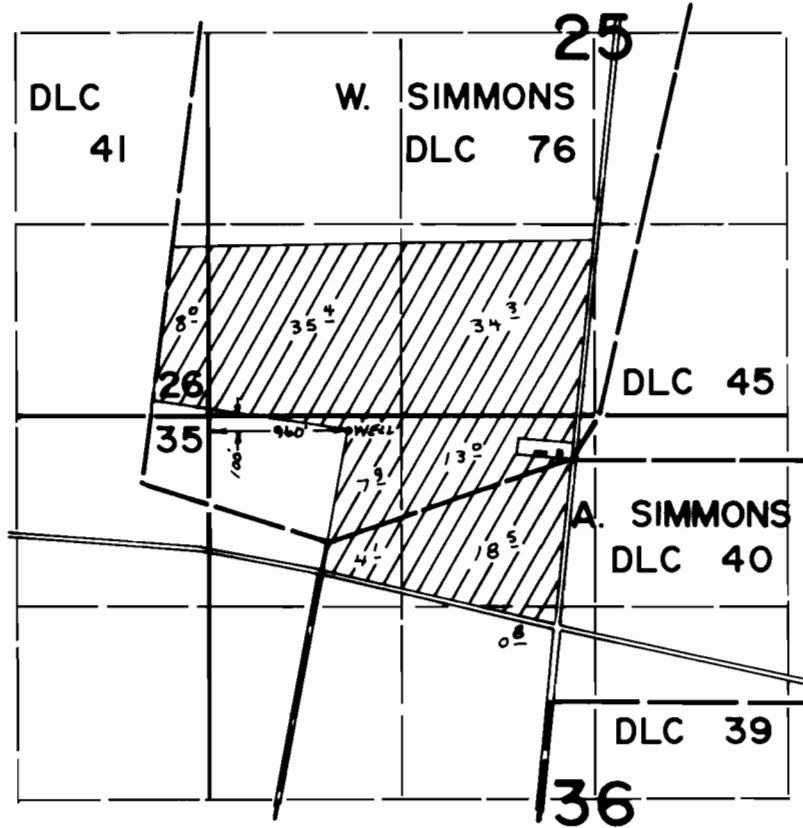

**FINAL PROOF SURVEY**  
UNDER

Application No. G-5548 Permit No. G-5426  
IN NAME OF

ANDREW SMITH

Surveyed MAY 18 1976, by L. T. GALT