T.6 S. R.2 W. W.M.

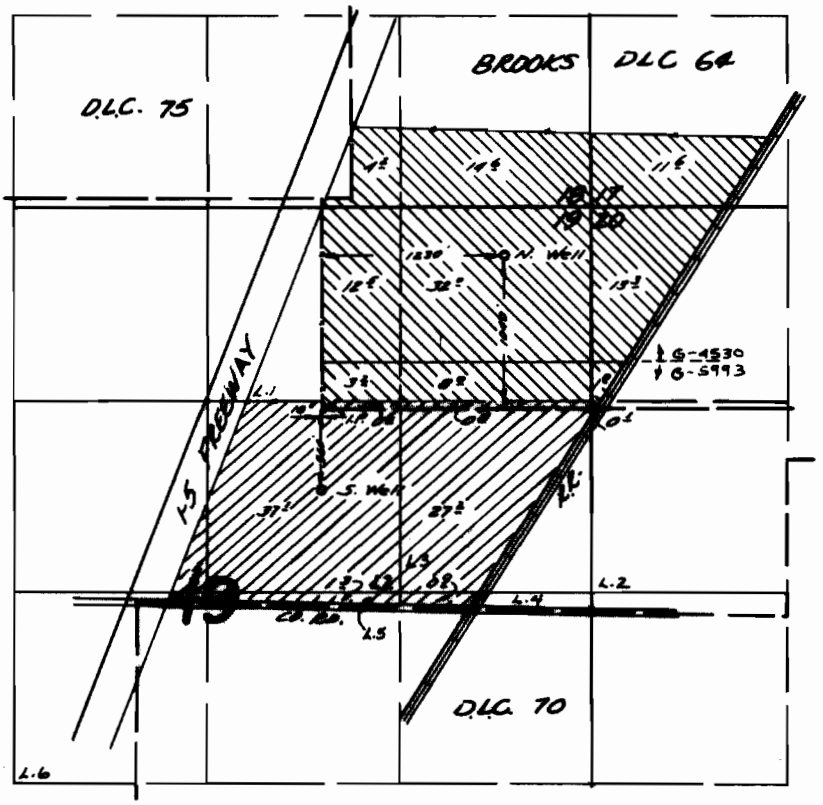

FINAL PROOF SURVEY
UNDER

Application No. ~~G-5293~~ G-4530 Permit No. ~~G-5708~~ G-4052

IN NAME OF

GEORGE N. HYBERTSEN

Surveyed MAY 21 1976, by L. TOLL

DFN-GLL-102