


# T.4S.,R.1W.,W.M.

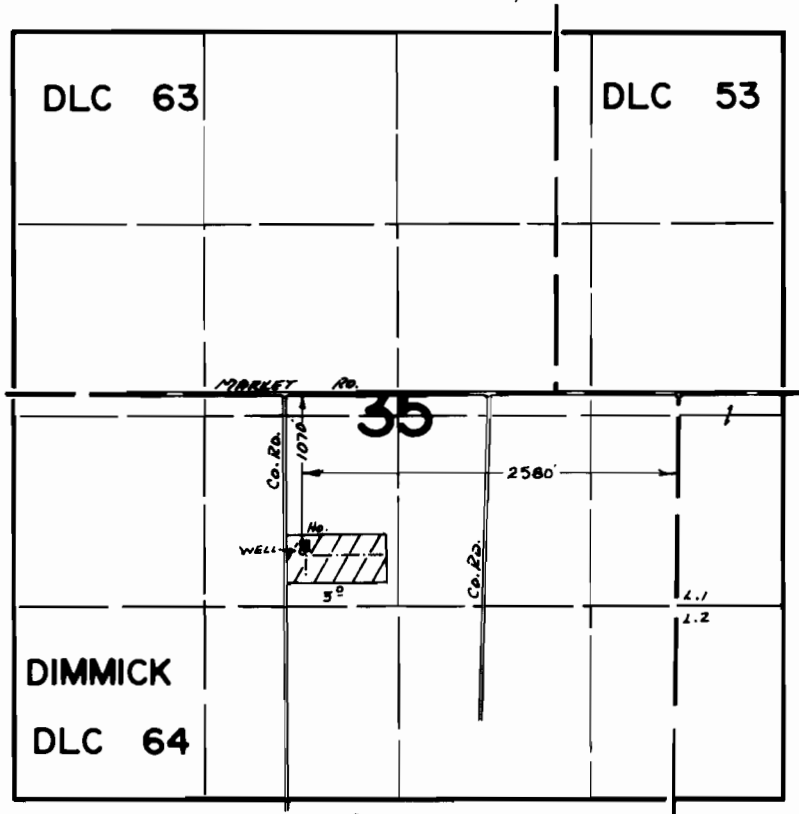

## FINAL PROOF SURVEY UNDER

Application No. G-6112... Permit No. G-5786  
IN NAME OF

LEE L. MCFARLAND

Surveyed APRIL 22, 1976, by L. TOLL