


T.6S.,R.2W.,W.M.

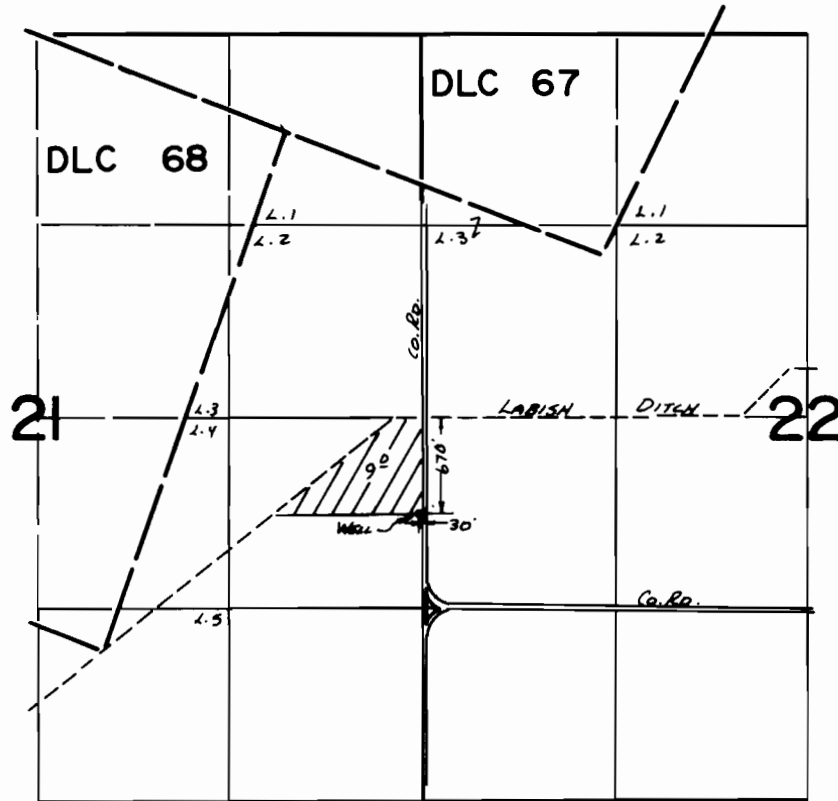

FINAL PROOF SURVEY
UNDER

Application No. G-6130 Permit No. G-5800
IN NAME OF

ARTHUR J. & LILLIAN G. RASMUSSEN

Surveyed JUNE 4, 1976, by L. TOLL