


T.4S.,R.IW,W.M.

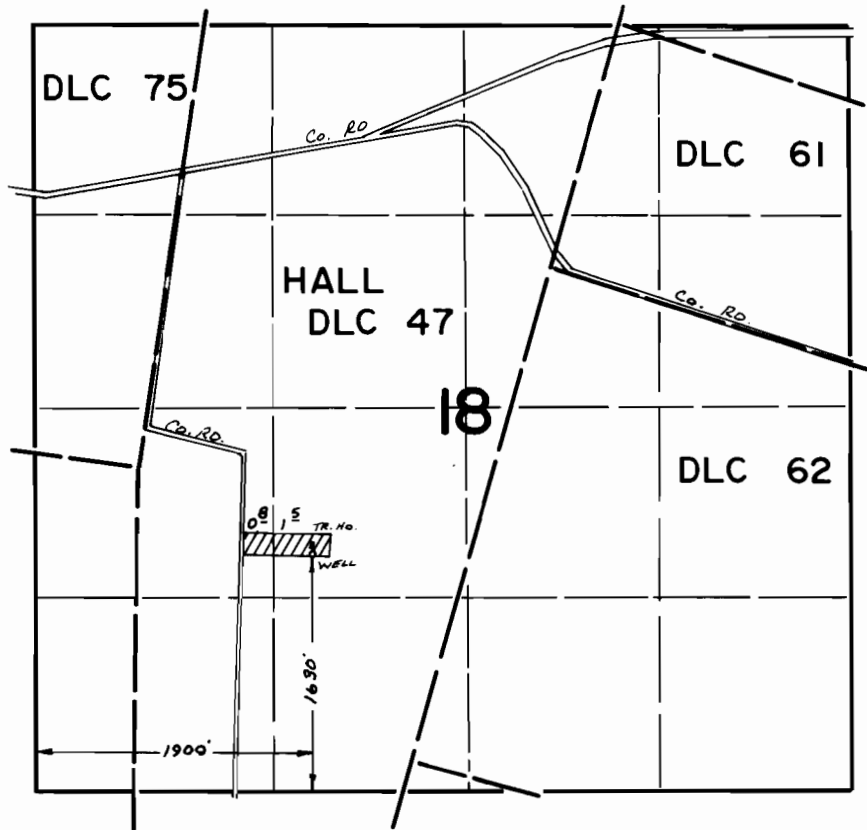

FINAL PROOF SURVEY UNDER

Application No. G-6289. Permit No. G-5918.
IN NAME OF

SYLVESTER PAVLICEK

Surveyed APRIL 23, 1976, by L. TOLL