


T.4S.,R.2W.,W.M.

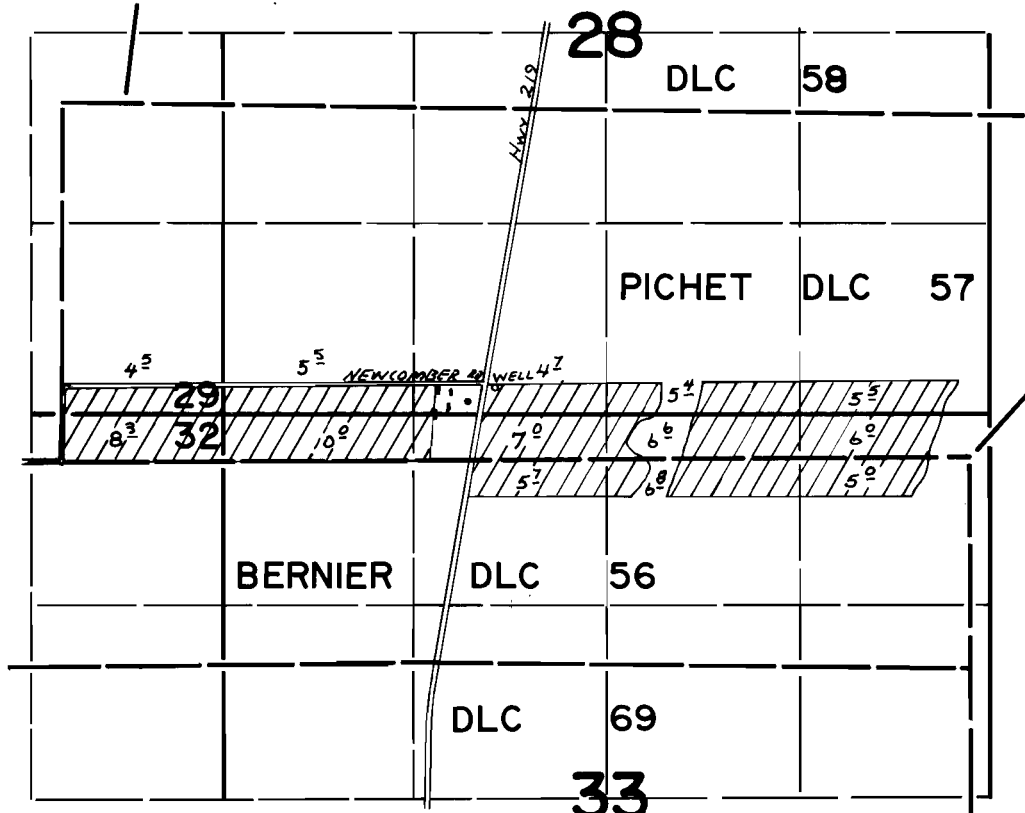

WELL LOC: 500' N & 2970' E. FROM S.W. COR. PICHET DLC 57

FINAL PROOF SURVEY UNDER

Application No. G-6447 Permit No. G-6048
IN NAME OF

MATT VACHTER

Surveyed APRIL 19, 1976, by L. TOLL